


T. 38 S., R. 4 & 5 W., W. M.

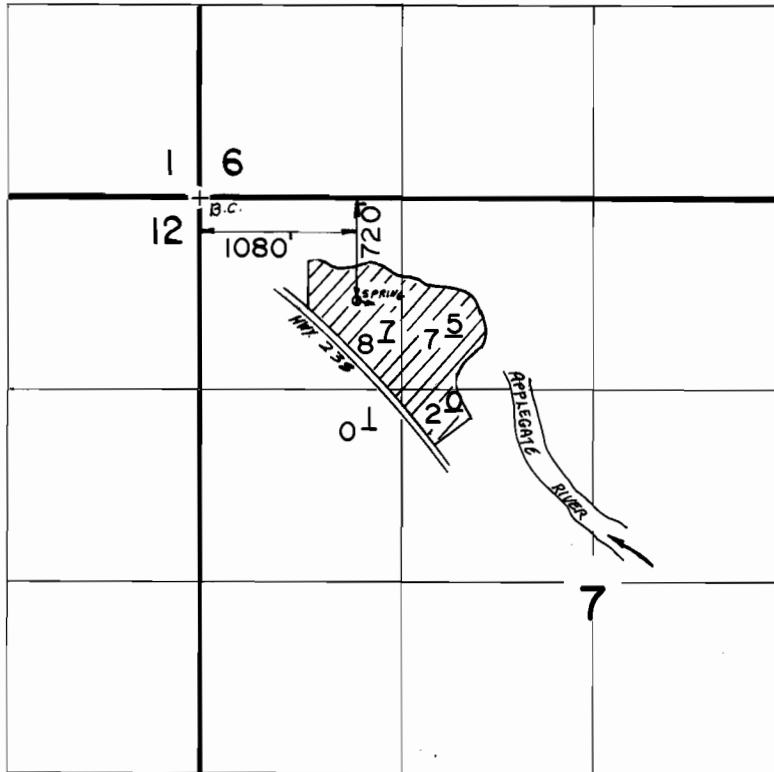

Scale: 1" = 1320'

FINAL PROOF SURVEY
UNDER

Application No. 65025 Permit No. 47468
IN NAME OF

BERTEENA, WESLEY & JOHN HILL

Surveyed FEB. 9, 1988, by B. S. JAMES.