


T. 37 S., R. 6 W., W. M.

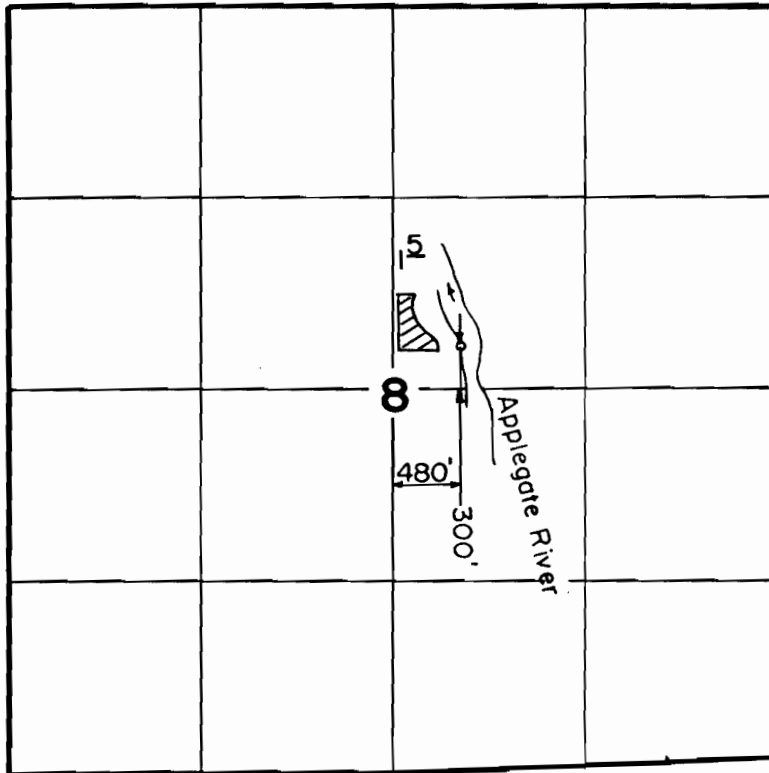

Scale: 1" = 1320'

FINAL PROOF SURVEY
UNDER

Application No. 65067 Permit No. 47802...
IN NAME OF

.....RUSSELL E. BURCH.....

Surveyed AUG. 29. 1988, by B. S. JAMES...