


T. 4S., R. 40E., W.M.

SECTION 2 SW1/4 SE1/4

SCALE 1" = 400'

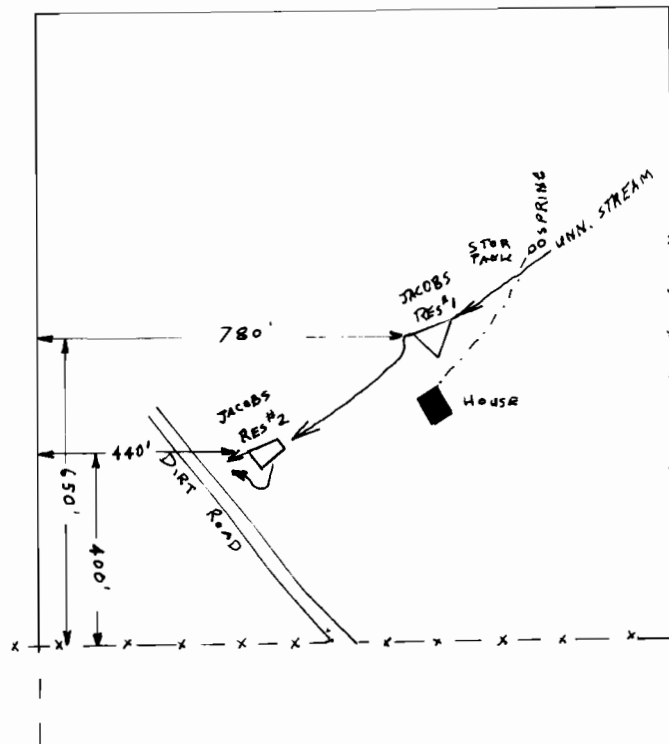

FINAL PROOF SURVEY
UNDER

Application No. R-65205... Permit No. R-8805.....
IN NAME OF

ALBERT E. JACOBS

Surveyed SEPT....8.... 19.8.8., by V.L. CHURCH.....