


T. 13 S., R. 9 E., W.M.
SECTION 10

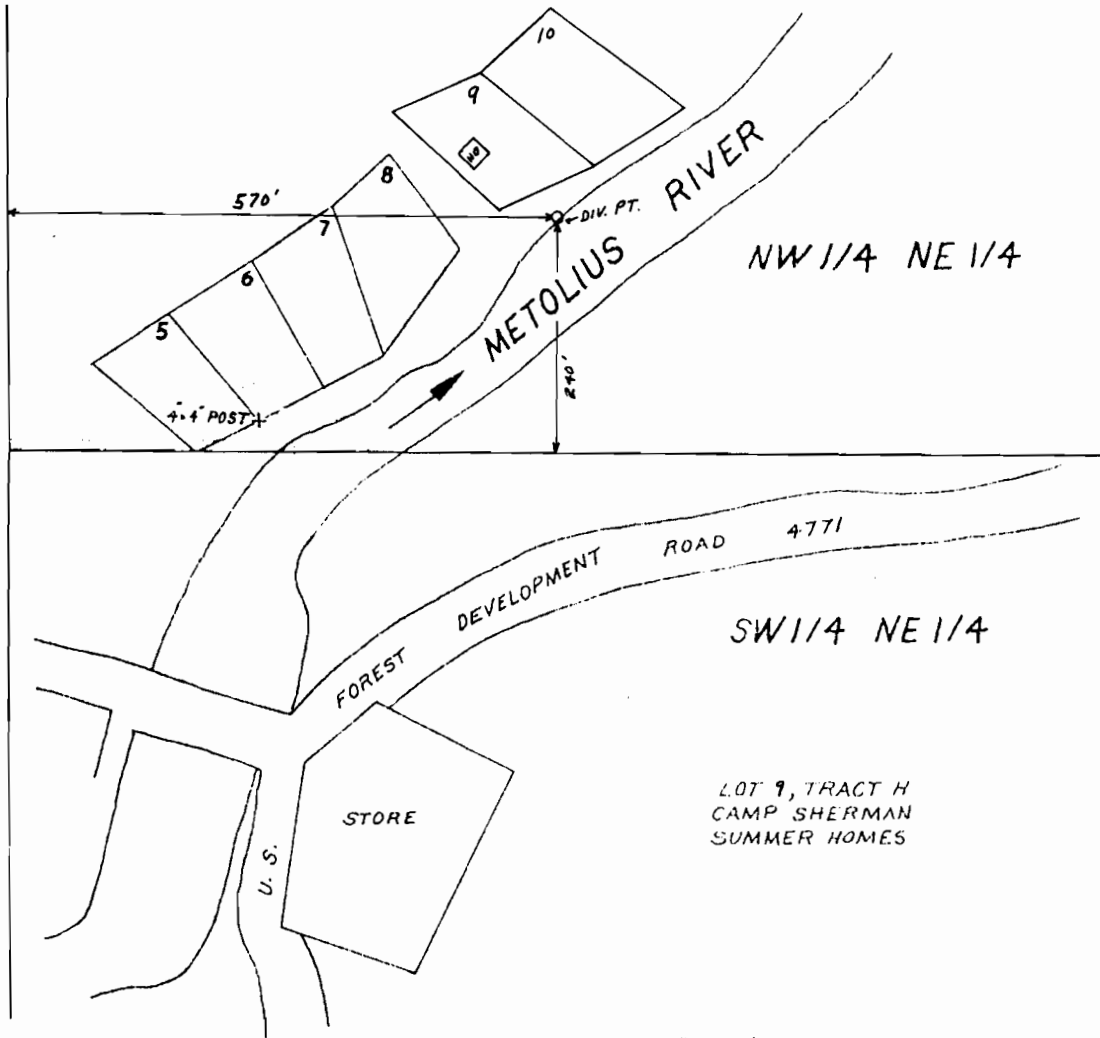

SCALE: 1" = 200'

FINAL PROOF SURVEY
UNDER

Application No. 65492 Permit No. 48066
IN NAME OF

TOMAS FINNEGAN RYAN

Surveyed MAY 17 1988, by B. BISHOP