

RECEIVED

JAN 12 1984

SECTION 10 T. 35. N. 34. W. W.M.
CURRY COUNTY
1" = 400' 800'

R-67918

Permit No. **48298**

WATER RESOURCES DEPT.
SALEM, OREGON


SEE MAP 31 15 3

NO. **9919**
R **9534**

RECEIVED

OCT 14 1983

WATER RESOURCES DEPT.
SALEM, OREGON

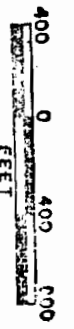

X red X in dimension

Point to take water from A.

to fill ponds, wells were portable for pumps

where \odot is marked to irrigate

South end of fields, X marker spot started from

to decide starting point

for dimension point for

pond filling, N.W. corner

of the S.E. $\frac{1}{4}$ of N.W. $\frac{1}{4}$ of Sec 10

T.W. 31 - R. 15 240'

East to no. main circle 130'

South 640'

East from starting point to

main creek 80' South

See Map 31 15

See Map 31 15



See Map 31 15 15

31 15 10