


T.31S.,R15W., W. M.

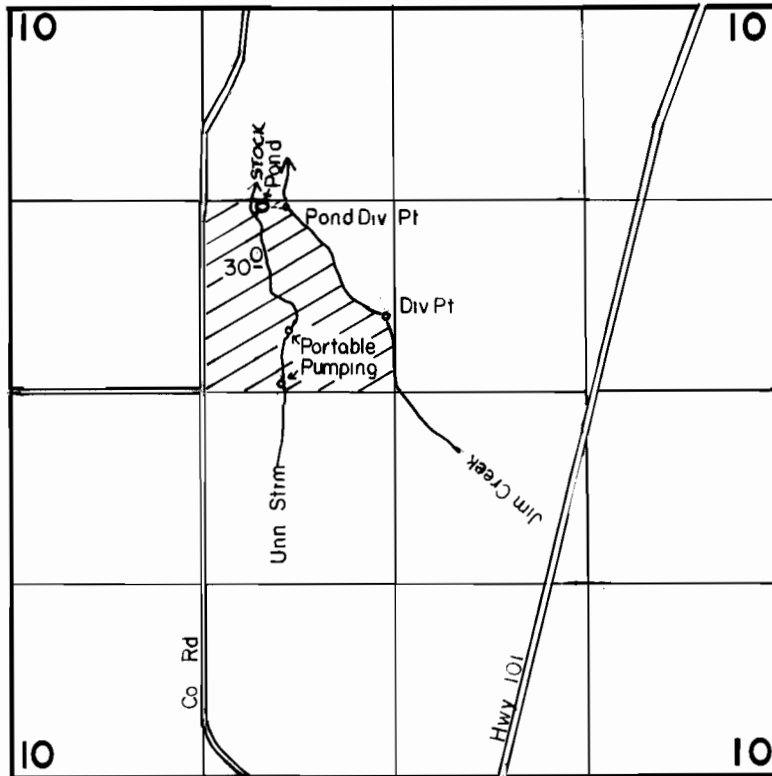

Pond Loc 1280' N & 1750' E, Pond Div Pt Loc 1280' N & 1900' E, Jim Cr Div Pt Loc 510' N & 2600' E, N Portable Pumping Div Pt Loc 420' N & 1920' E, S Portable Pumping Div Pt Loc 70' N & 1850' E, All From The W 1/4 Corner Of Section 10

SCALE: 1" = 1320'

FINAL PROOF SURVEY UNDER

R - 67918 R - 9534

Application No. ~~67919~~..... Permit No. ~~48298~~.....

IN NAME OF

..... **HARRY STRAIN**

Surveyed AUG...... 1989., by B. S. JAMES.....