



T. 14S., R. 5W., W.M.

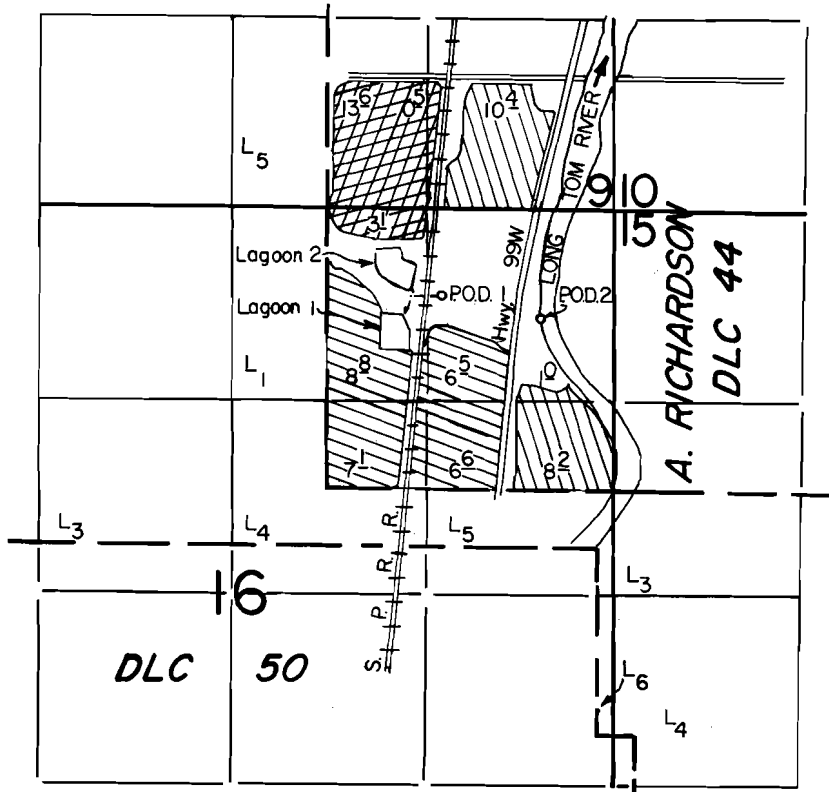

P.O.D. 1 Loc. : 600' S. & 1190' W.
 P.O.D. 2 Loc. : 750' S. & 500' W., both from NE Cor. Sec. 16.

Scale : 1" = 1320'

FINAL PROOF SURVEY UNDER

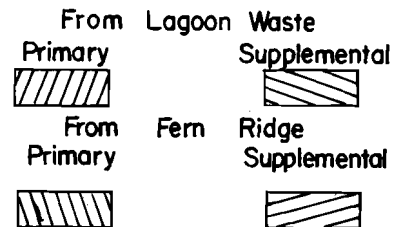

R-68099 R-10060
 Application No. 68100 Permit No. 49024
 IN NAME OF

GEORGE HORNING

Surveyed AUG. 24 1988, by T. Warren