


T. 1 N., R. 15 E., W.M.

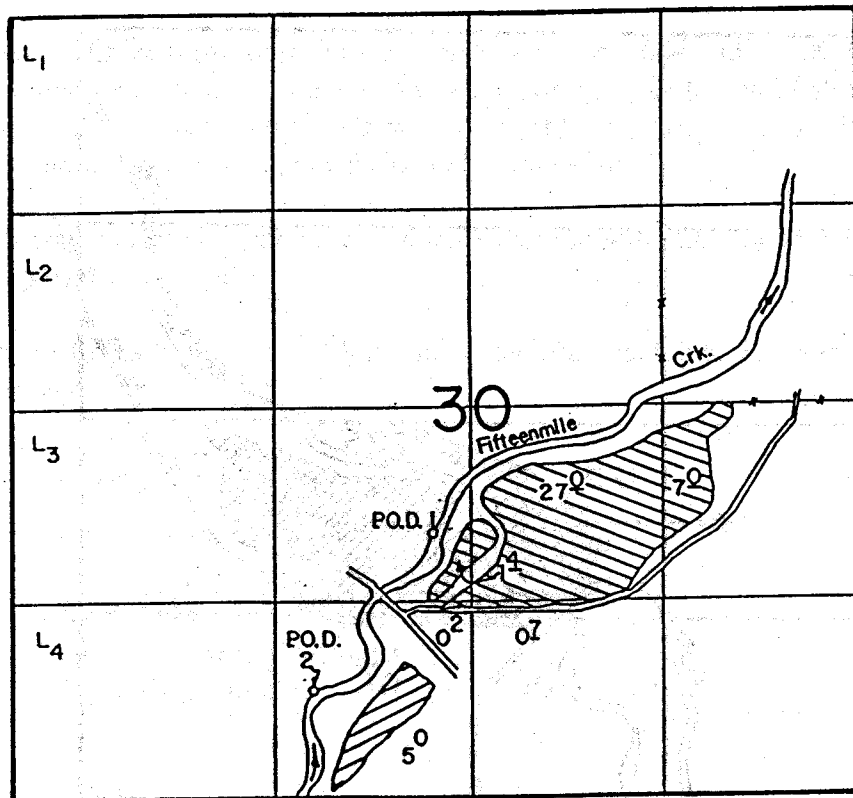

P.O.D. 1 Loc.: 850' S. & 1560' W.

P.O.D. 2 Loc.: 1900' S. & 2390' W., both from NE Cor. NW⁴ SE⁴ Sec. 30.

Scale : 1" = 1320'

FINAL PROOF SURVEY
UNDER

C-65609

Application No. 68114... Permit No. 49182.....
IN NAME OF

.....CLIFFORD S. BAKER.....

Surveyed JUNE...8... 1988., by ..T...Warren.....

41065-179-34-R
2/1/07 TAW