


T. 4 S, R. 4 W, W.M.

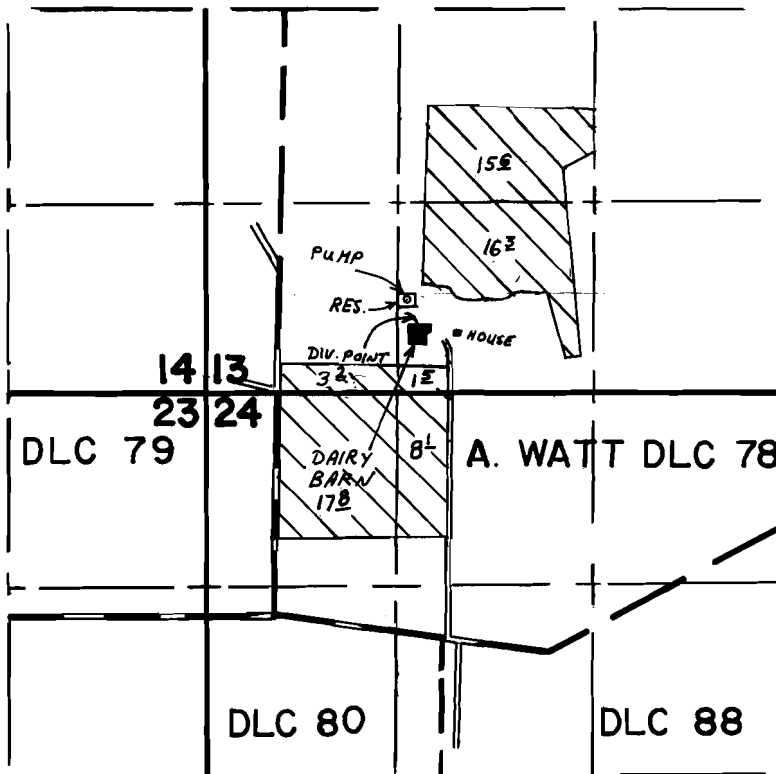

DIV. POINT : 450' N, & 1460' E FROM SW CORNER SEC. 13
 RESERVIOR : 580' N, & 1350' E FROM SW CORNER SEC. 13

SCALE 1" = 1320'

FINAL PROOF SURVEY

UNDER

R-68178

R-9974

Application No. 68179 Permit No. 48767

IN NAME OF

FOREST GLEN OAK, INC.

Surveyed AUG. 4 1988 by Z. SALEH