


T. 26 S., R. 3 W., W.M.

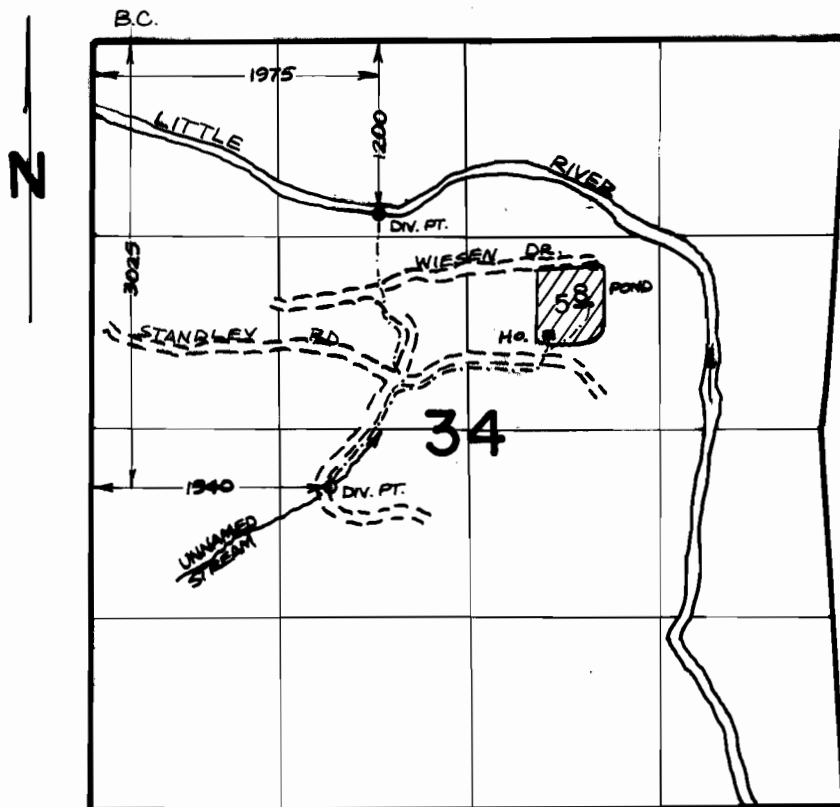

SCALE : 4" = 1 MILE

FINAL PROOF SURVEY UNDER

Application No. .68205.. Permit No. .48995.....
IN NAME OF

JOHN T. JONES JR. & DIANE M. JONES

Surveyed .FEB..12., 19.88, by .J.M.SCHMORDE.