


# T. 28 S., R. 14 W., W.M.

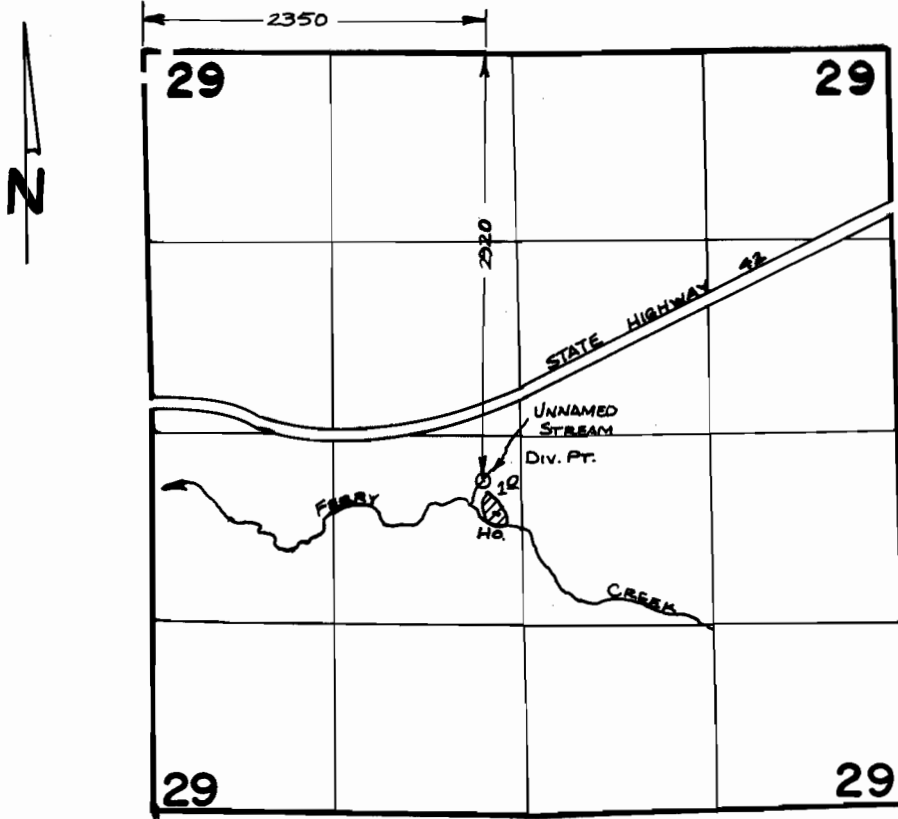

SCALE: 4" = 1 MILE

## FINAL PROOF SURVEY UNDER

Application No. ..68469 Permit No. ...49643.....  
IN NAME OF

.....HOWARD...CUNNINGHAM.....

Surveyed ...8/23, 1988, by ...M.SCHMORDE....