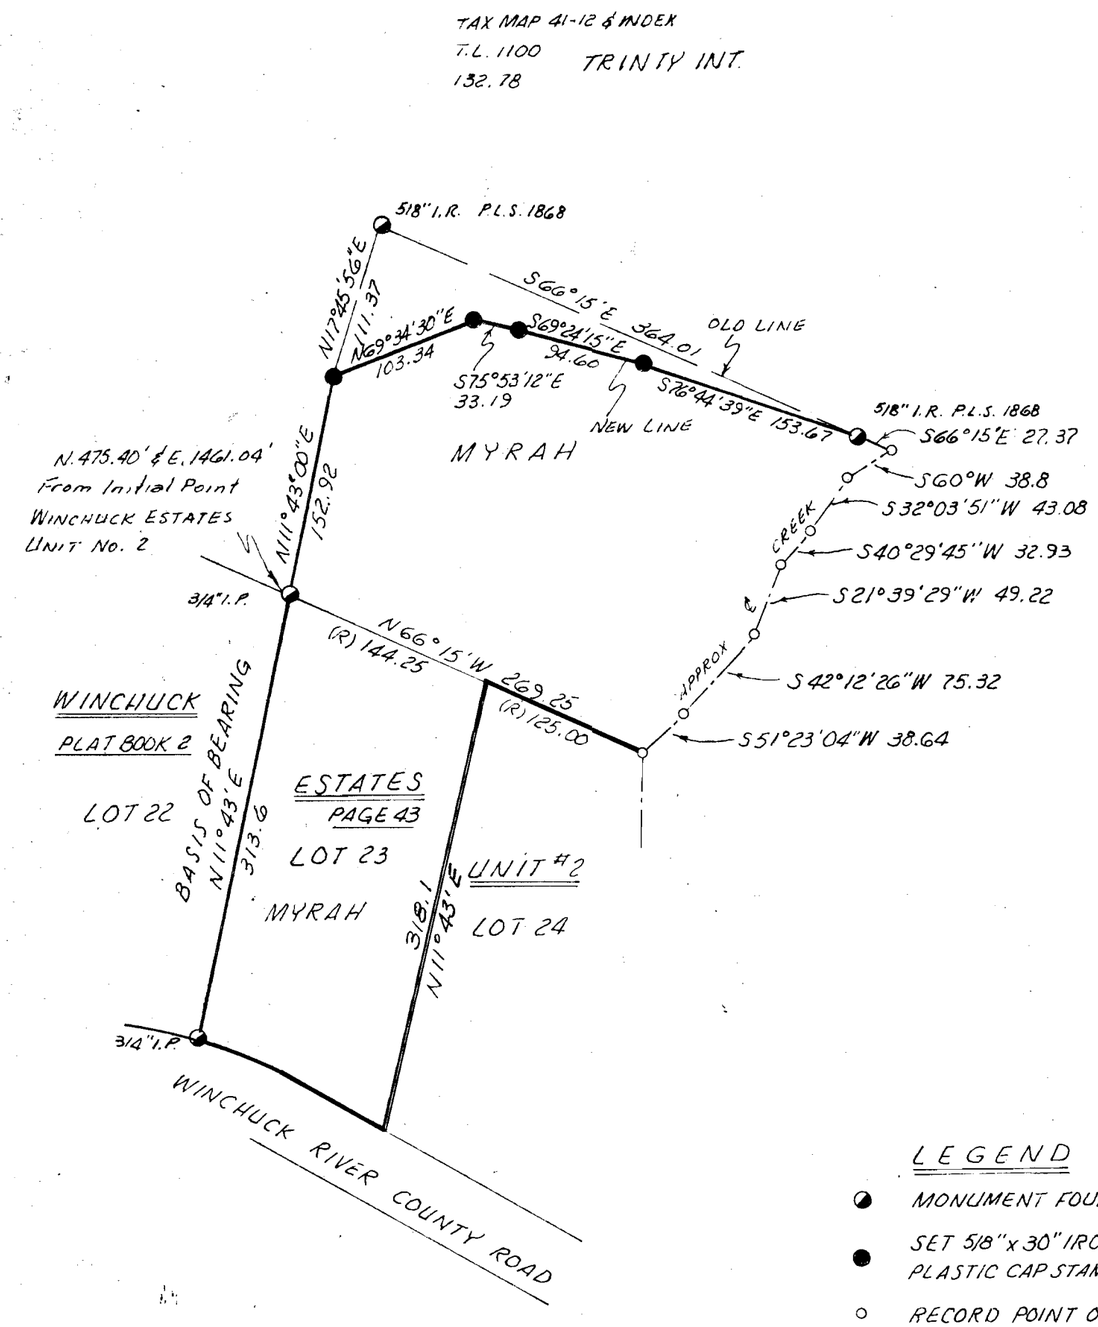

NARRATIVE:

THIS SURVEY WAS PERFORMED AT THE REQUEST OF GORDON MYRAH TO SURVEY A LOT LINE ADJUSTMENT OF A PREVIOUSLY SURVEYED PARCEL.

THE BASIS OF BEARING WAS THE FOUND NW CORNER AND SW CORNER OF SAID LOT 23, WINCHUCK ESTATES UNIT NO. 2 AS RECORDED IN PLAT BOOK 2, PAGE 43, OFFICIAL RECORDS OF CURRY COUNTY.

THIS SURVEY IS TO ADJUST THE NORTH LINE OF THAT SURVEY MADE IN AUG. 1985.

SCALE 1" = 100"

OCTOBER, 1985

MAP OF SURVEY

OF A PARCEL OF LAND LYING WITHIN SECTION 6, T. 41S., R. 12 W., W.M., CURRY COUNTY, OREGON

FOR

GORDON MYRAH

BROOKINGS, OREGON 97415

BY

B AND D SURVEYS, Ltd.
411 MILL BEACH ROAD
BROOKINGS, OREGON 97415
PHONE (503) 469-5329

LEGEND

- ◐ MONUMENT FOUND (AS NOTED)
- ● SET 5/8" x 30" IRON ROD W/YELLOW PLASTIC CAP STAMPED P.L.S. 1868
- ○ RECORD POINT ONLY

RECEIVED
JAN 13 1986
WATER RESOURCES DEPT
SALEM, OREGON

1596