




T. 4 S., R. 2 E., W.M.

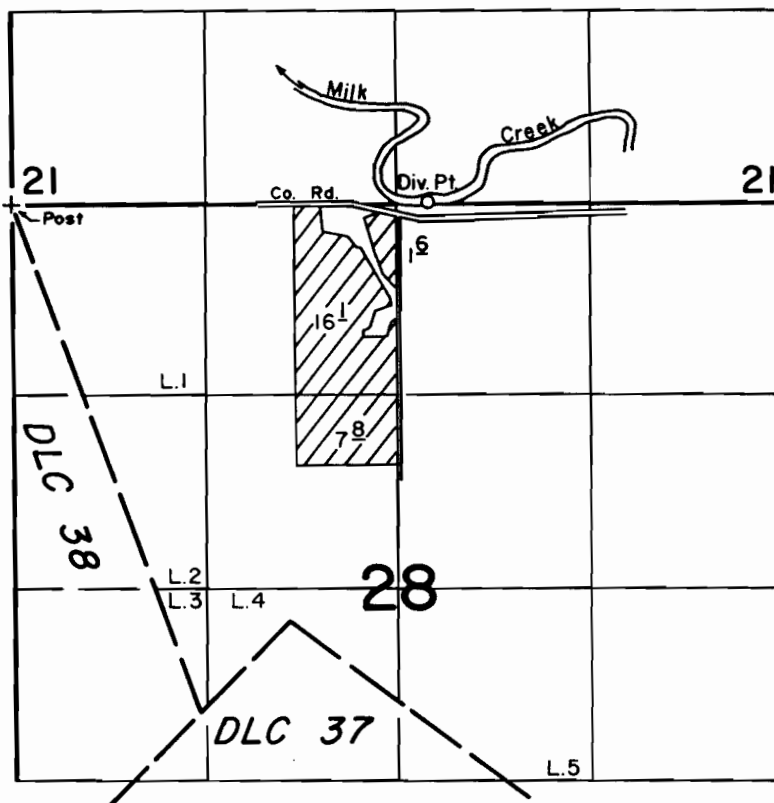

DIV. PT. LOC.: 10' N. & 2870' E. FROM THE S.W. CORNER SECTION 21

SCALE: 1" = 1320'

FINAL PROOF SURVEY UNDER

Application No. 68678. Permit No. 49658.....
IN NAME OF

HANS P. ZENTHOEFER

Surveyed MAY 19 1989, by R. W. KLASSEN.....