


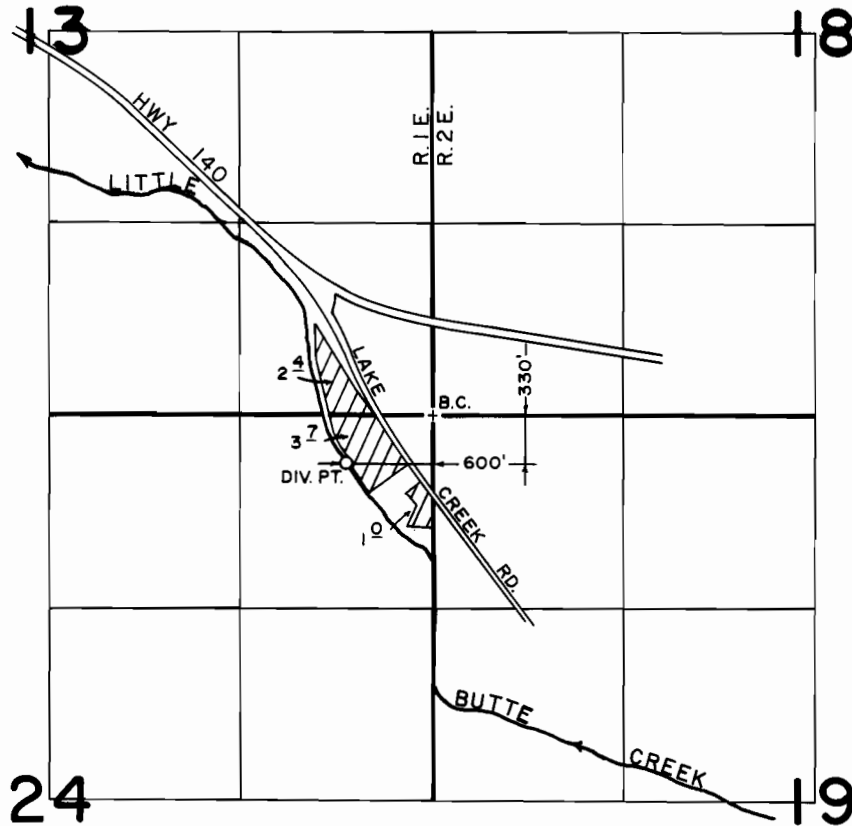

T. 36 S., R. 18 & 2 E., W.M.



SCALE: 1" = 1320'

**FINAL PROOF SURVEY**  
UNDER

Application No. 68686.. Permit No. 49877.....  
IN NAME OF

**RICHARD K. & DARLENE N. McCULLOCH**

Surveyed MAY 31, 1989, by B. S. JAMES.....