


T. 4 S., R. 2 W., W.M.

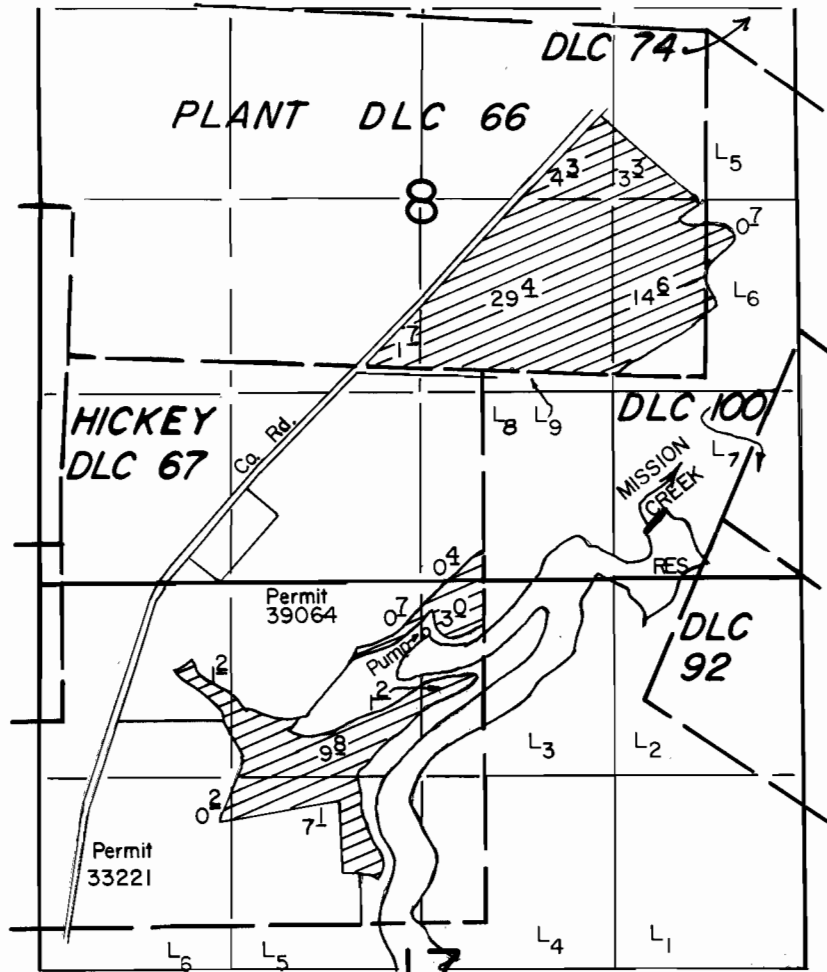

P.O.D. Loc. : 2750' N. & 1150' E. from SE Cor. DLC 67.

Scale : 1" = 1320'

FINAL PROOF SURVEY UNDER

Application No. 68718... Permit No. 49700.....

IN NAME OF

GERALD P. & KATHLEEN A. MULLEN

Surveyed AUG. 25. 1989, by R. KLASSEN.....

41047-278-32B
PTS w/FF
3/26/90 TMW