



12	7
13	18

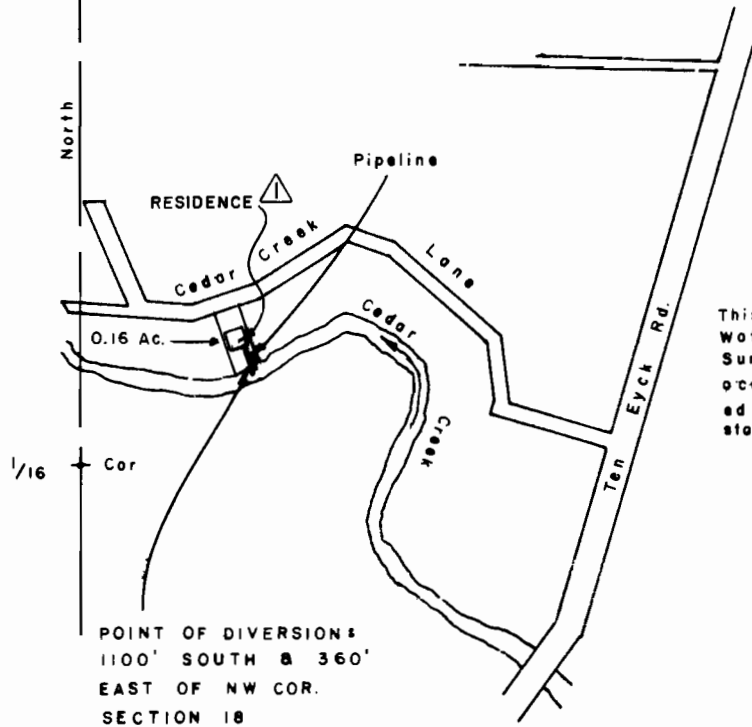

Scale: 1" = 400'


This drawing is an exhibit for a Surface Water Right Final Proof Map. It is not a Land Survey. Property lines and/or other lines of occupation shown hereon are not represented by the undersigned to meet accuracy standards of Land Surveys.

Paul & Sharon Boerckel[△]
 NW 1/4 NW 1/4 Section 18
 T.2S, R.5E. W.M.
 CLACKAMAS COUNTY, OR.

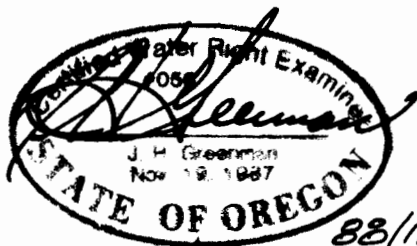

Application No. 69526
 Permit No. 50190

REVISION [△] 9/12/90

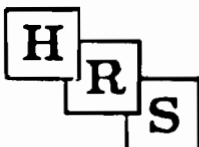

**HANER, ROSS &
 SPORSEEN, INC.**
 15 S.E. 82ND DR.
 GLADSTONE, OREGON 97027

**SURFACE WATER RIGHT
 FINAL PROOF MAP**