


T.33S., R.1E., W. M.

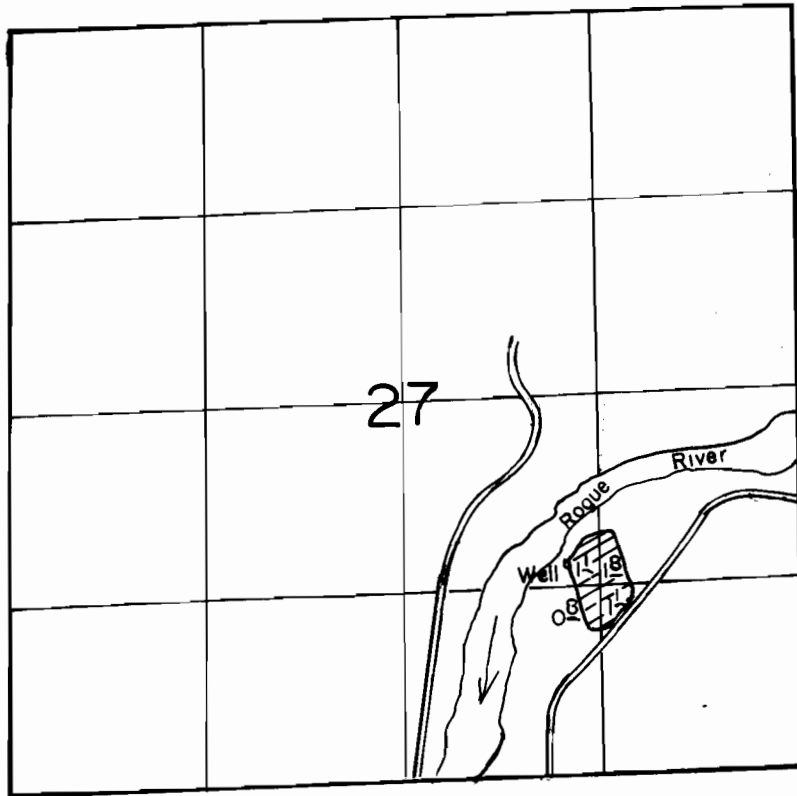

Well Located 1450' N & 1570' W From The SE Corner Of Section 27

SCALE: 1" = 1320'

**FINAL PROOF SURVEY
UNDER**

Application No. G-9401 Permit No. G-8785
IN NAME OF

CORPS OF ENGINEERS

Surveyed MAY. 14. 19.90., by B.S. JAMES