


T. 33 S., R. 1 E., W. M.

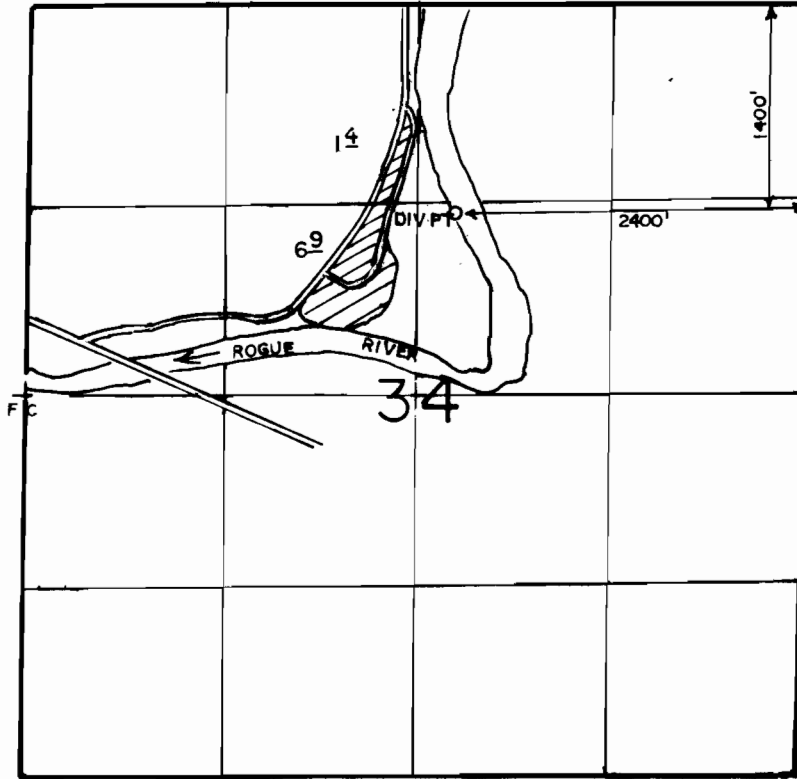

SCALE: 1" = 1320'

**FINAL PROOF SURVEY
UNDER**

Application No. 5.05.93. Permit No. 38235.....
IN NAME OF

.....CORPS.....OF.....ENGINEERS.....

Surveyed MAY.14. 1990., by B.S. JAMES.....