


T. 5 S., R. 1 E., W. M.

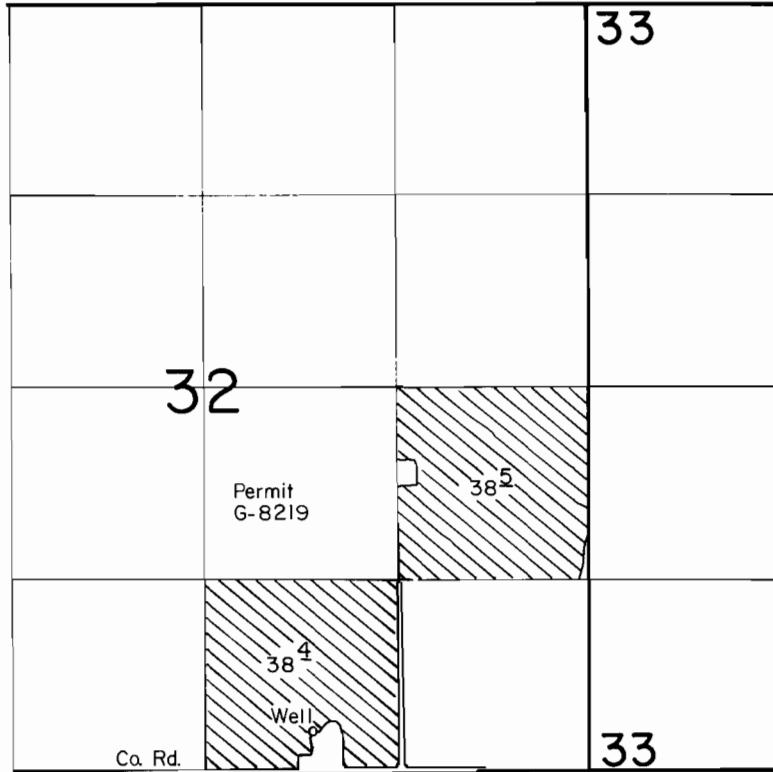

Well Loc. : 230' N. & 600' W. from SE Cor. SW 1/4 SE 1/4 Sec. 32

Scale : 1" = 1320'

**FINAL PROOF SURVEY**  
UNDER

Application No. G-11321 Permit No. G-10448  
IN NAME OF

MARGARETE or BRUCE LANDSEM

Surveyed AUG. 15. 1989. by J. Warren.....