


# T.5 S., R.1 E., W.M.

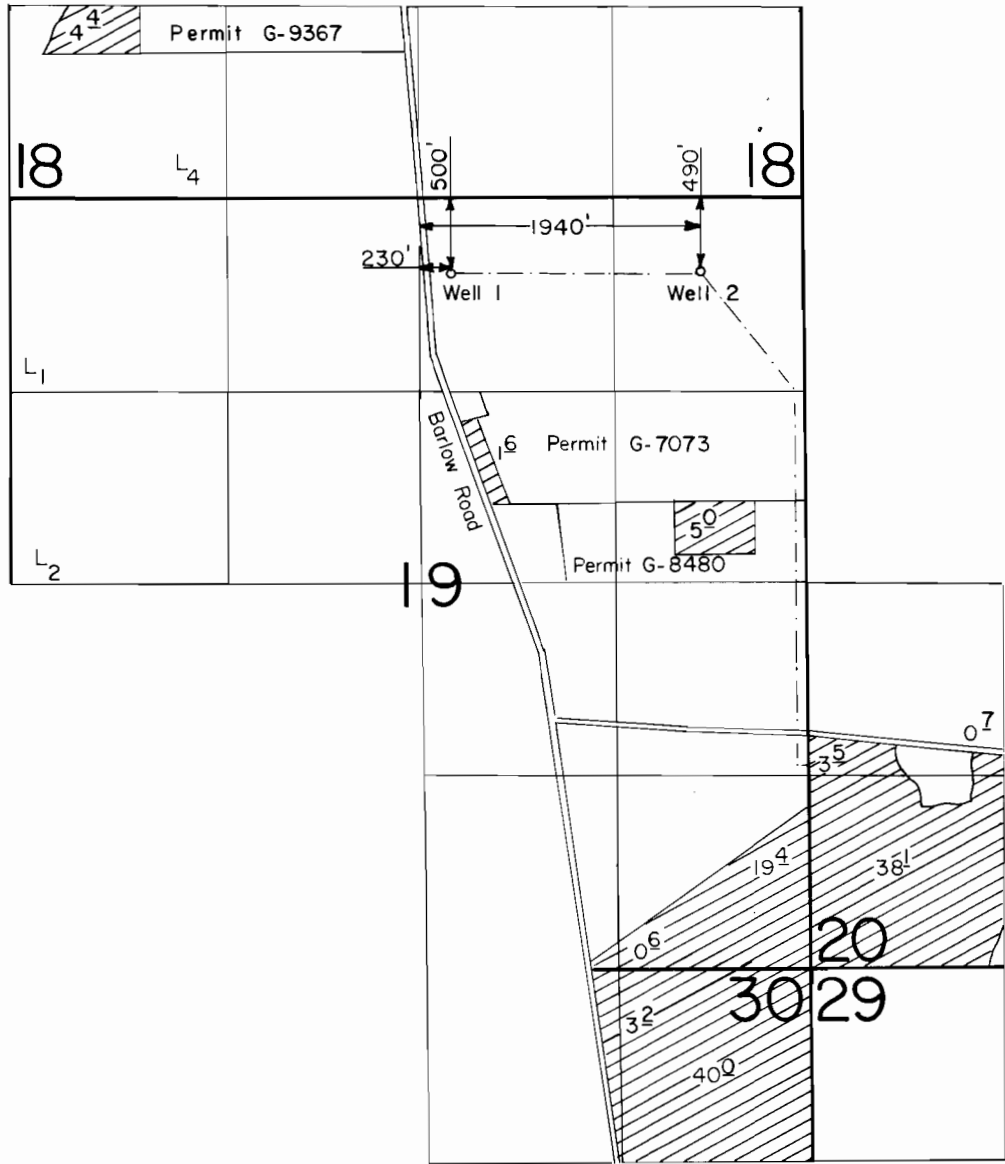

Scale : 1" = 1320'

## FINAL PROOF SURVEY UNDER

Application No. G-11342.. Permit No. G-10475..  
IN NAME OF

.....**HESSEL BIERMA**.....

Surveyed Nov. 3..... 1989., by T. Warren.....

DFK-2LL-24  
DFK-2LL-153

2/15/90 TMW