


SECTION 23, T.41S., R.20E., W.M.

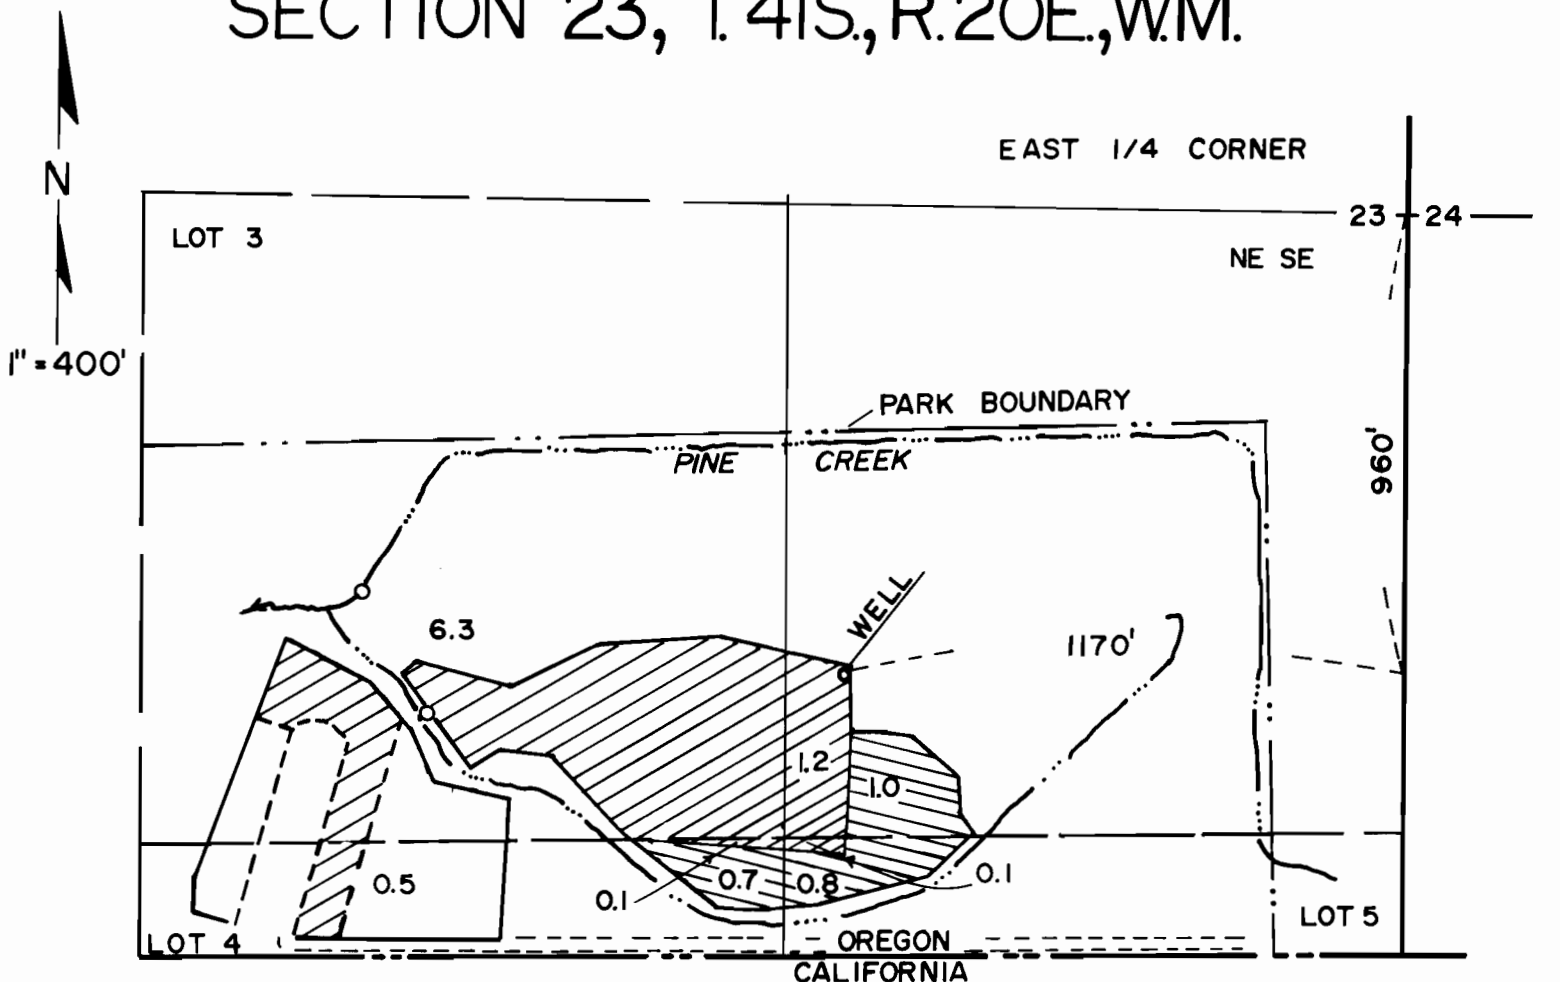

 PRIMARY

 SUPPLEMENTAL

FINAL PROOF SURVEY UNDER

Application No. G-11778


Permit No. G-10835

IN NAME OF

OREGON STATE PARKS DIVISION

Surveyed 9-19, 1989

by Arnold N. Slack

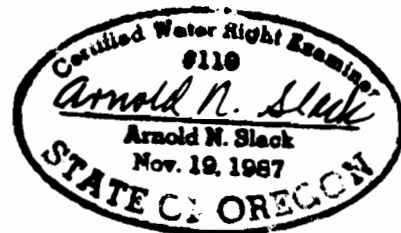

THE PURPOSE OF THIS MAP IS TO IDENTIFY THE LOCATION OF THE WATER RIGHT. IT IS NOT INTENDED TO PROVIDE INFORMATION RELATIVE TO THE LOCATION OF PROPERTY OWNERSHIP BOUNDARY LINES.