


50277
C-65632

RECEIVED

OCT 17 1989

SECTION 23, T.41S., R.20E., W.M.

WATER RESOURCES DIV.
SALEM, OREGON

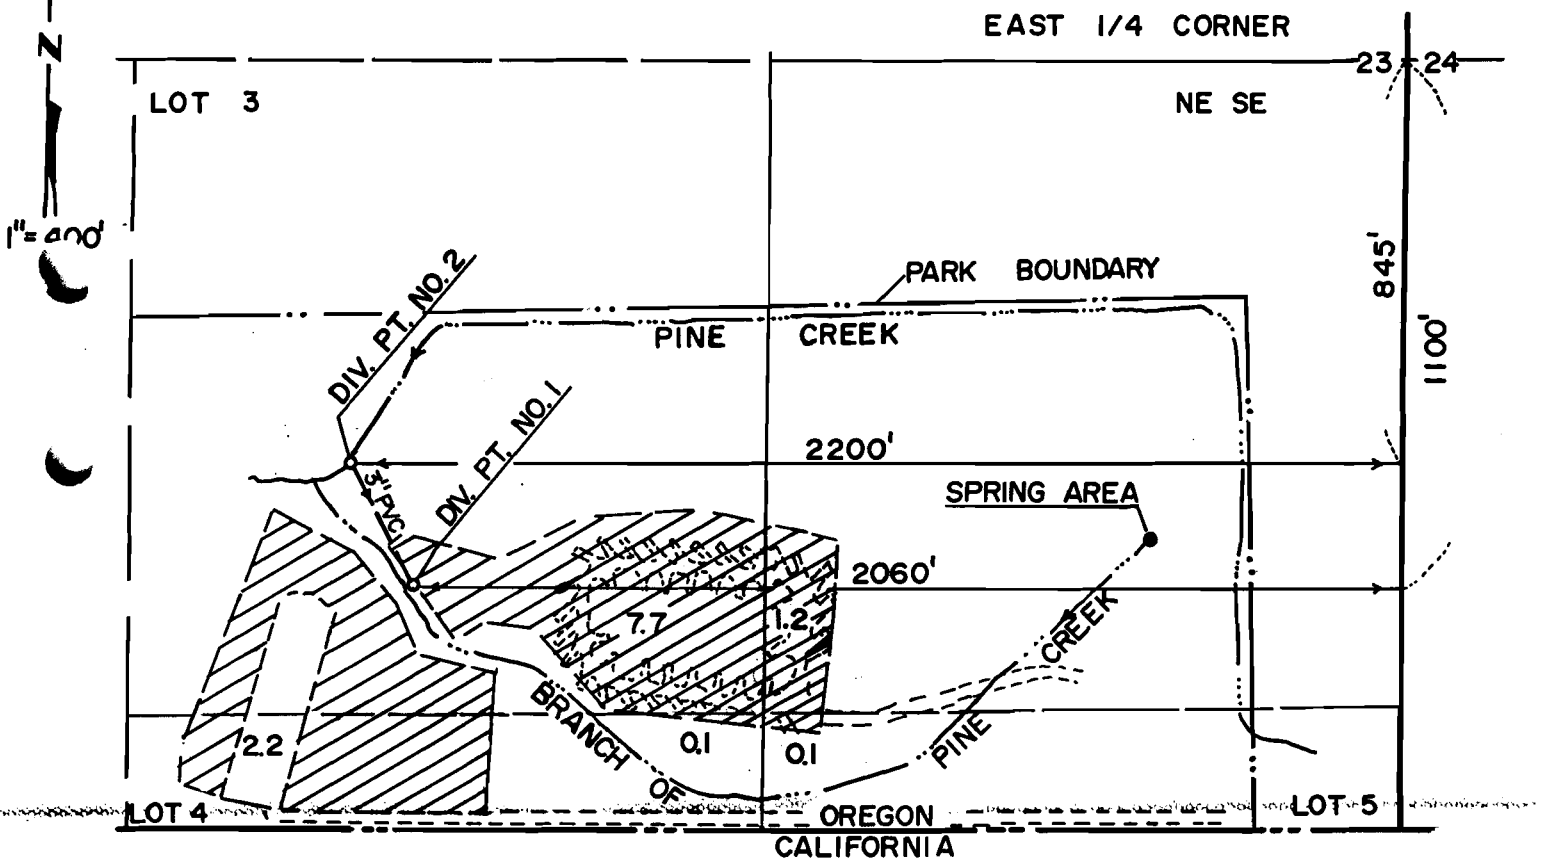

FINAL PROOF SURVEY
UNDER

Application No. 69530 Permit No. 50277

IN NAME OF

OREGON STATE PARKS DIVISION

WATER RIGHT
SALE

Surveyed.....9-19....., 1989

by Arnold N. Slack.

THE PURPOSE OF THIS MAP IS TO IDENTIFY THE
LOCATION OF THE WATER RIGHT. IT IS NOT INTENDED
TO PROVIDE INFORMATION RELATIVE TO THE
LOCATION OF PROPERTY OWNERSHIP BOUNDARY LINES.

