


T. 2S., R. 44E., W. M.

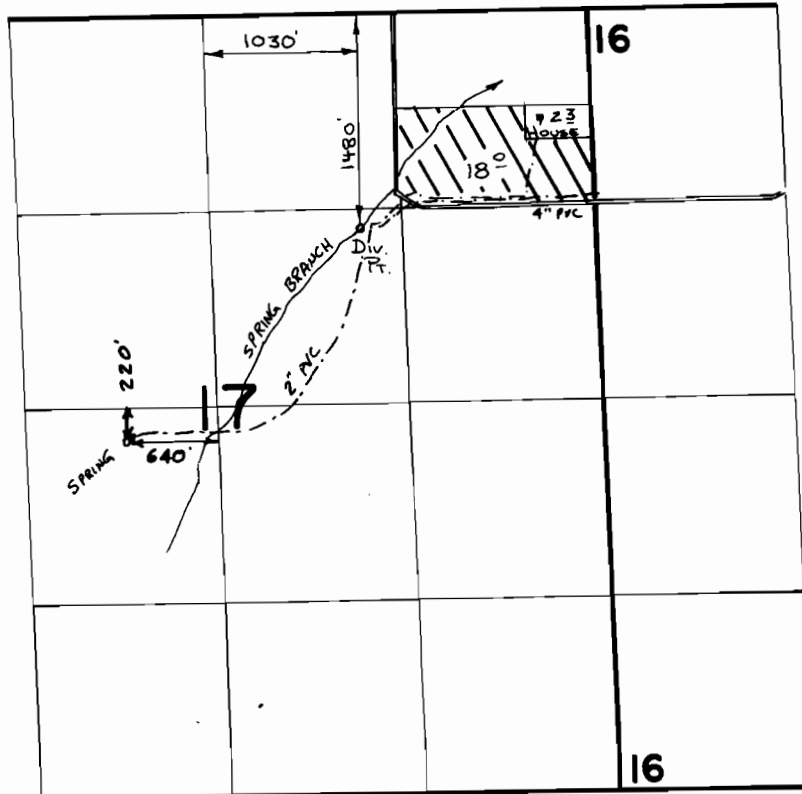

SCALE 1" = 1320

FINAL PROOF SURVEY
UNDER

50433 37781

Application No. **50059** Permit No. **36738**....
IN NAME OF

.....**RALPH W. SWINEHART**.....

Surveyed ~~AUGUST 30 1978~~, by ~~R. F. FARWIN~~....
OCTOBER 9, 1990 K. KEMP