


T. 35 S., R. 2 W., W.M.

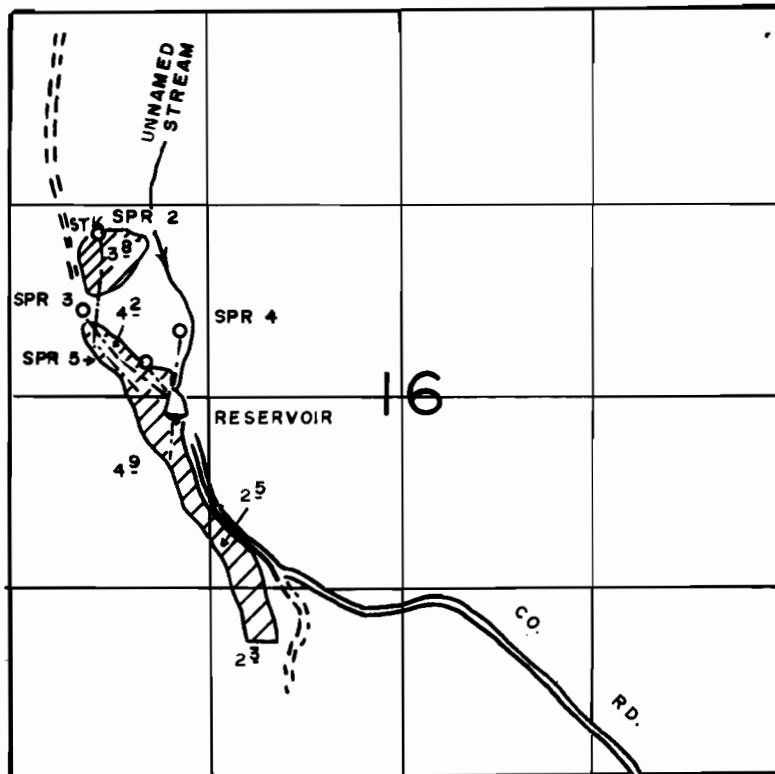

SPR 2 1090' N. & 560' E. FROM W. 1/4 COR. SEC. 16
 SPR 3 600' N. & 490' E. FROM W. 1/4 COR. SEC. 16
 SPR 4 420' N. & 1130' E. FROM W. 1/4 COR. SEC. 16
 SPR 5 230' N. & 950' E. FROM W. 1/4 COR. SEC. 16
 DAM LOCATED 170' S. & 1190' E. FROM W. 1/4 COR. SEC. 16

1" = 1320'

FINAL PROOF SURVEY UNDER

Application No. 50162 R-50161 Permit No. 37310 R-6055
 IN NAME OF

JEAN KORNER

Surveyed FEB. 26 1990, by B. S. JAMES