




T. 13 S., R. 16 E., W.M.

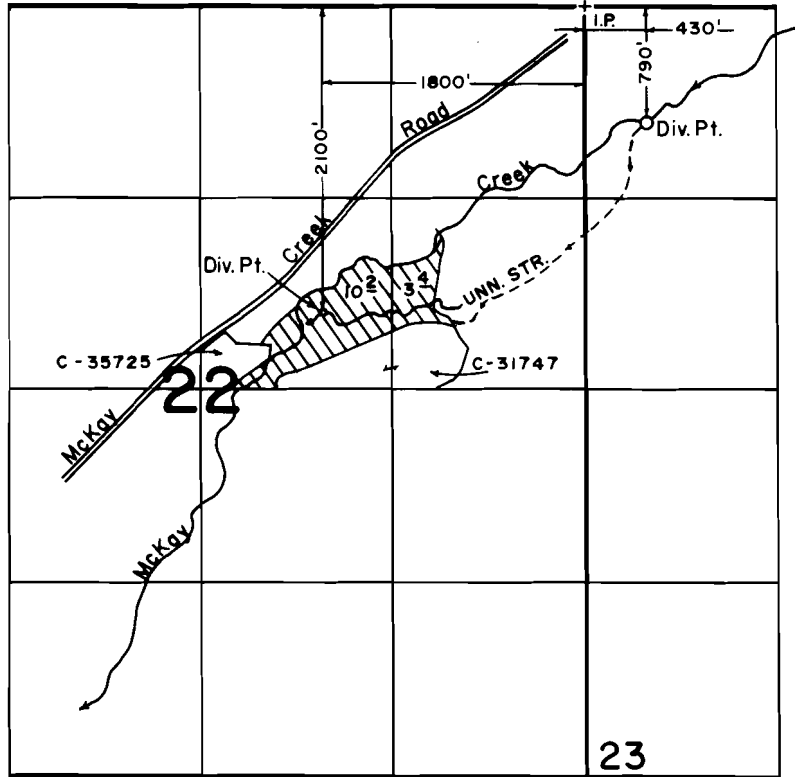

SCALE: 1" = 1320'

FINAL PROOF SURVEY
UNDER

Application No. 53500.. Permit No. 40048.....
IN NAME OF

ROBERT J. MILLER

Surveyed DEC. 27. 1989., by B. W. BISHOP.....