


T.34S, R.6W, W.M.

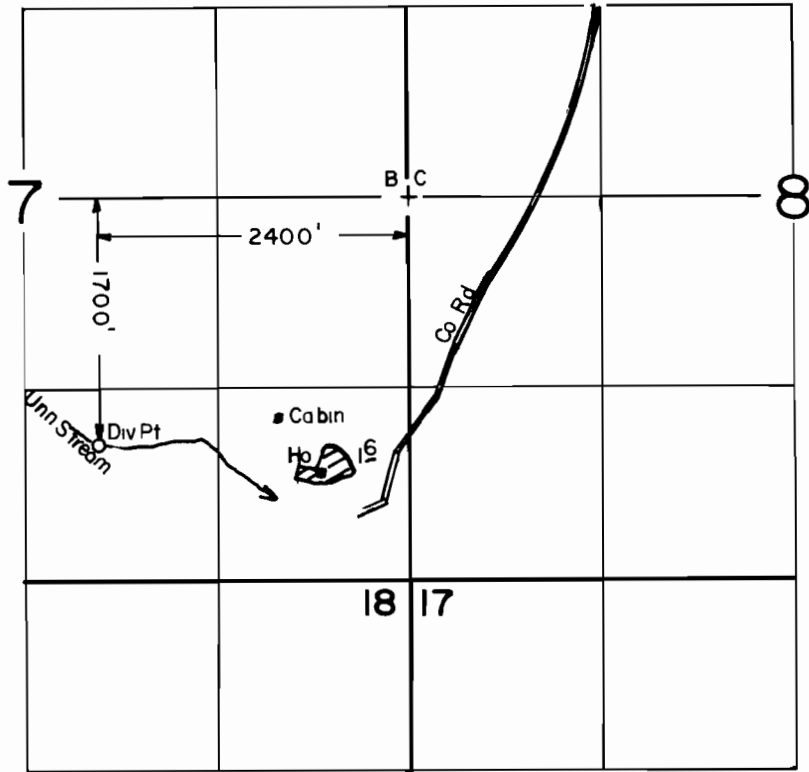

SCALE: 1" = 1320'

**FINAL PROOF SURVEY**  
UNDER

Application No. 53623... Permit No. 40328.....

IN NAME OF  
**JOE KASSEL**  
..... **GARY & ETHEL ACKERMAN** .....

Surveyed MAY...2.... 1989., by B.S. JAMES.....