


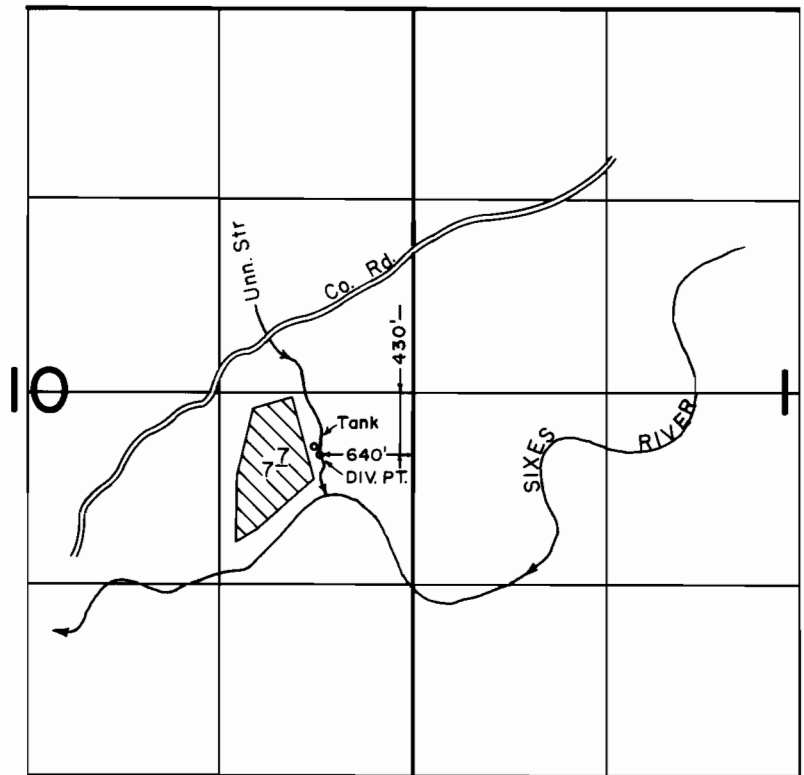

T. 32 S., R. 13 W., W.M.



SCALE: 1" = 1320'

**FINAL PROOF SURVEY**  
UNDER

Application No. 53644. Permit No. 38637....  
IN NAME OF

**GEORGIA PACIFIC CORPORATION**

Surveyed SEPT. 21, 1989, by B. S. JAMES....