


T.2 S., R.46 E., W.M.

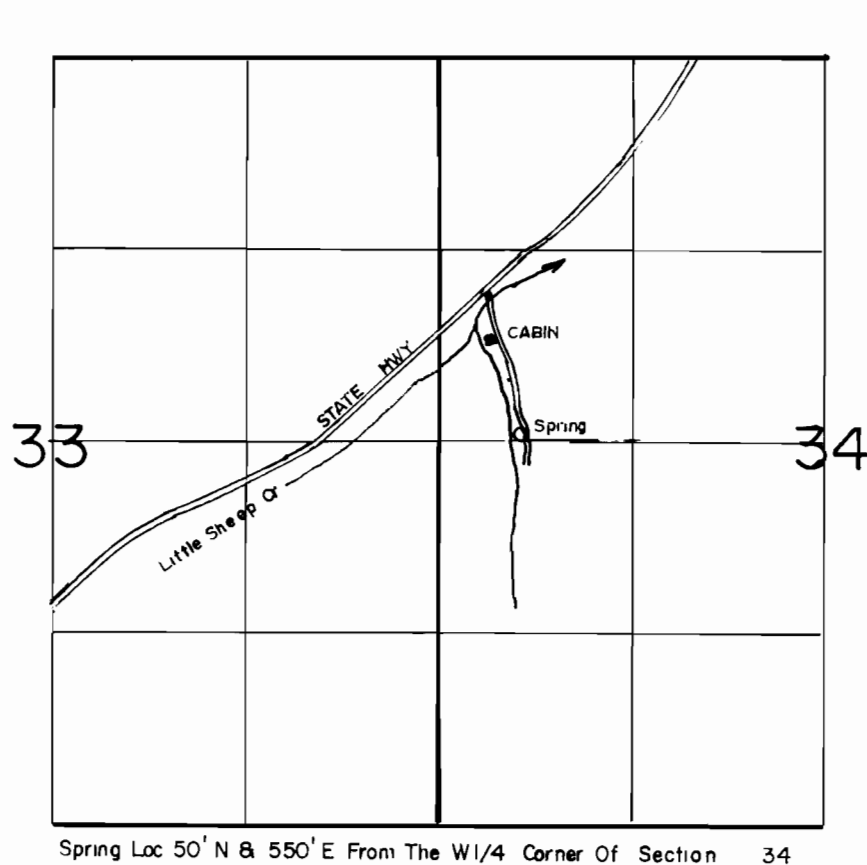

Spring Loc 50' N & 550' E From The W1/4 Corner Of Section 34

SCALE: 1"=1320'

FINAL PROOF SURVEY UNDER

Application No. 53900.... Permit No. 40459.....
IN NAME OF

WILLIAM L. & RETHA M. WALKER...

Surveyed APRIL 7, 1989, by Robert DeBow.....