


40766
65644

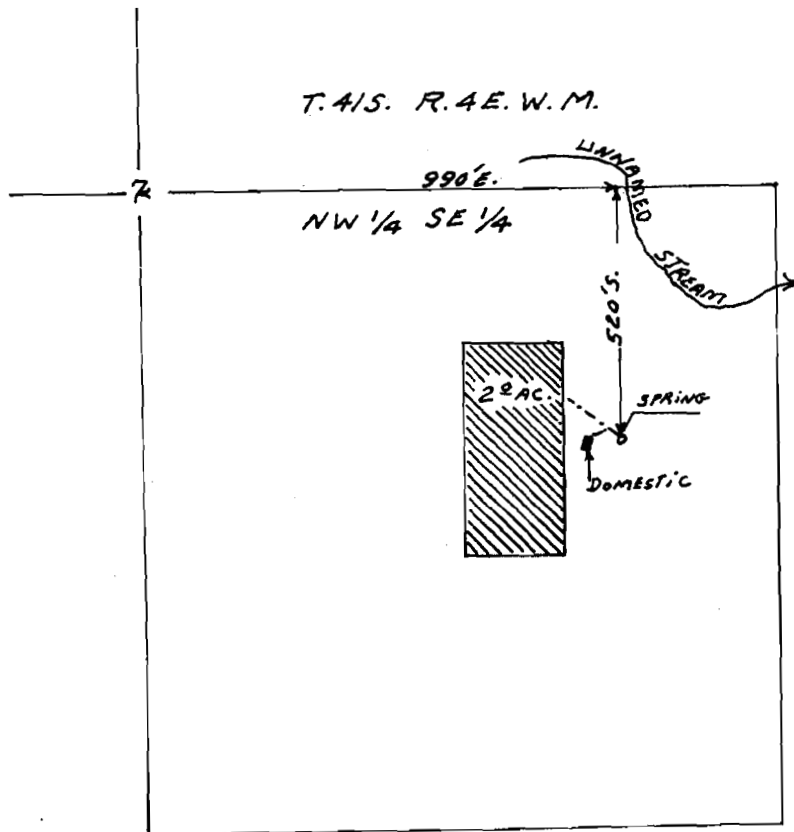

MAP TO ACCOMPANY APPLICATION OF
GEORGE F. WRIGHT FOR IRRIGATION
AND DOMESTIC USE FROM A SPRING


SCALE 1" = 400'

Application No. 54399
Permit No. 40766

RECEIVED

JUN 17 1976

WATER RESOURCES DEPT
SALEM, OREGON

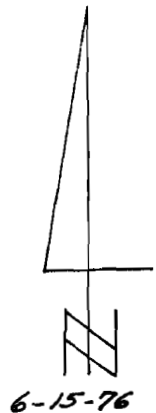

6-15-76