


T.41S., R.4E., W. M.

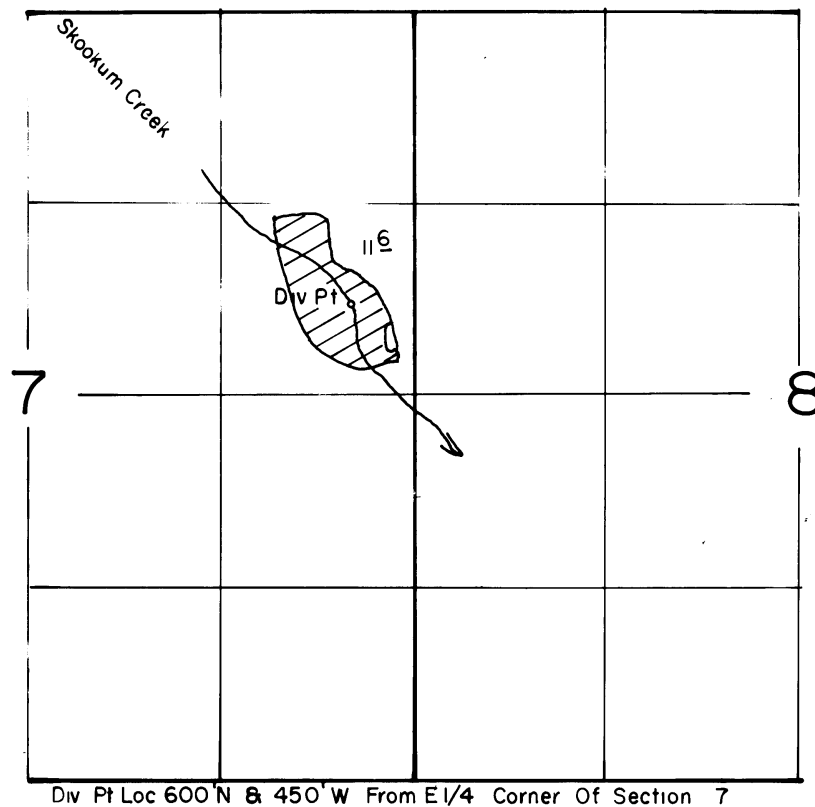

SCALE: 1"=1320'

FINAL PROOF SURVEY
UNDER

Application No. 54402... Permit No. 40767.....
IN NAME OF

.....**WINIFRED**.....**MILLER**.....

Surveyed AUG.22. 19.8.9., by B.S.JAMES.....