



T. 2S., R. 12E., W.M.

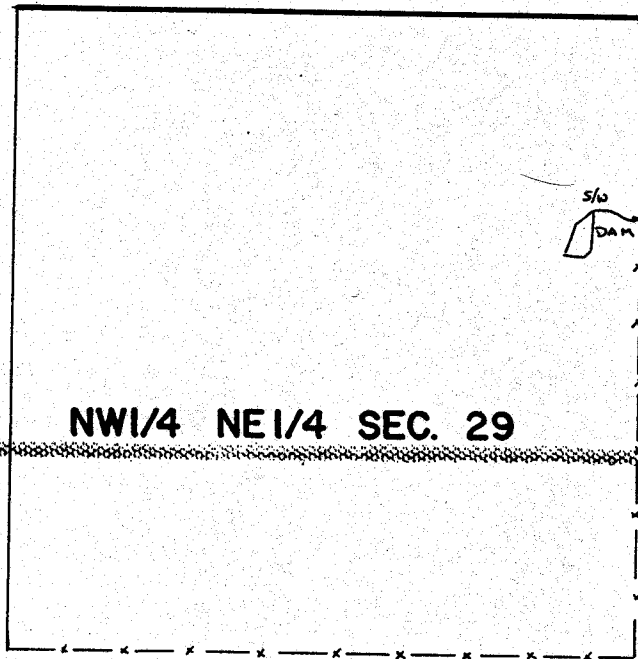

NW 1/4 NE 1/4 SEC. 29

5/0
DAM

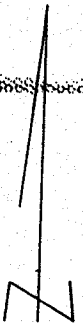

SCALE 1" = 400'

FINAL PROOF SURVEY
UNDER

Application No. **R:55265** Permit No. **R:6604**
IN NAME OF

RALPH.....**ODEGARD**..

Surveyed *4-18*..... 19*88*., by *V.L. Church*.....

PTS

4-26-89 VLC