


T.39S., R.12W., W.M.

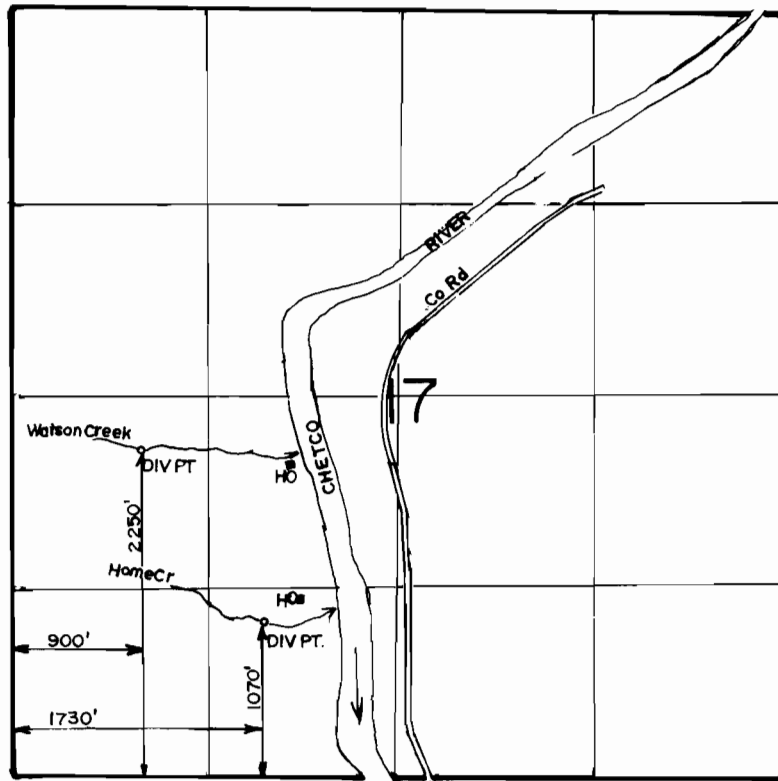

SCALE: 1"=1320'

**FINAL PROOF SURVEY
UNDER**

Application No. 55310..... Permit No. 41485.....

IN NAME OF
RICK REILING
.....**SALMONS LEAP INC.**.....

Surveyed JULY 27.. 1989., by B.S.JAMES.....