



T. 35 S., R. 7 W., W. M.

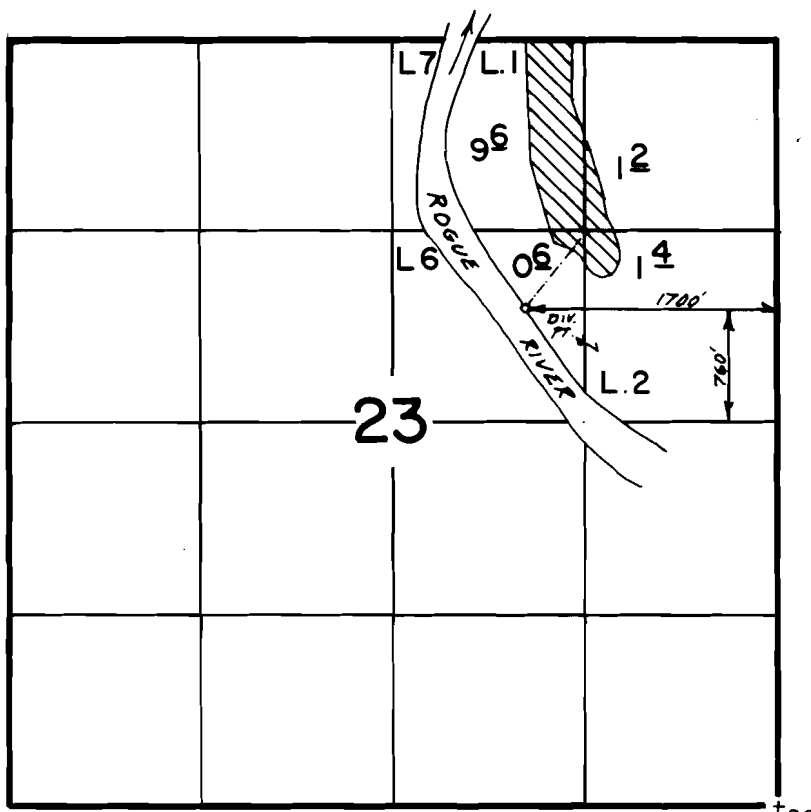

Scale : 1" = 1320'

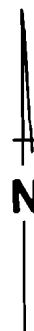

FINAL PROOF SURVEY UNDER

Application No. ~~55626~~ Permit No. ~~41676~~.....
IN NAME OF

.....**FREDERICK PONTE**.....

Surveyed Oct. 26, 1987, by B.S. JAMES.....