


T. 30 S., R. 11 W., W.M.

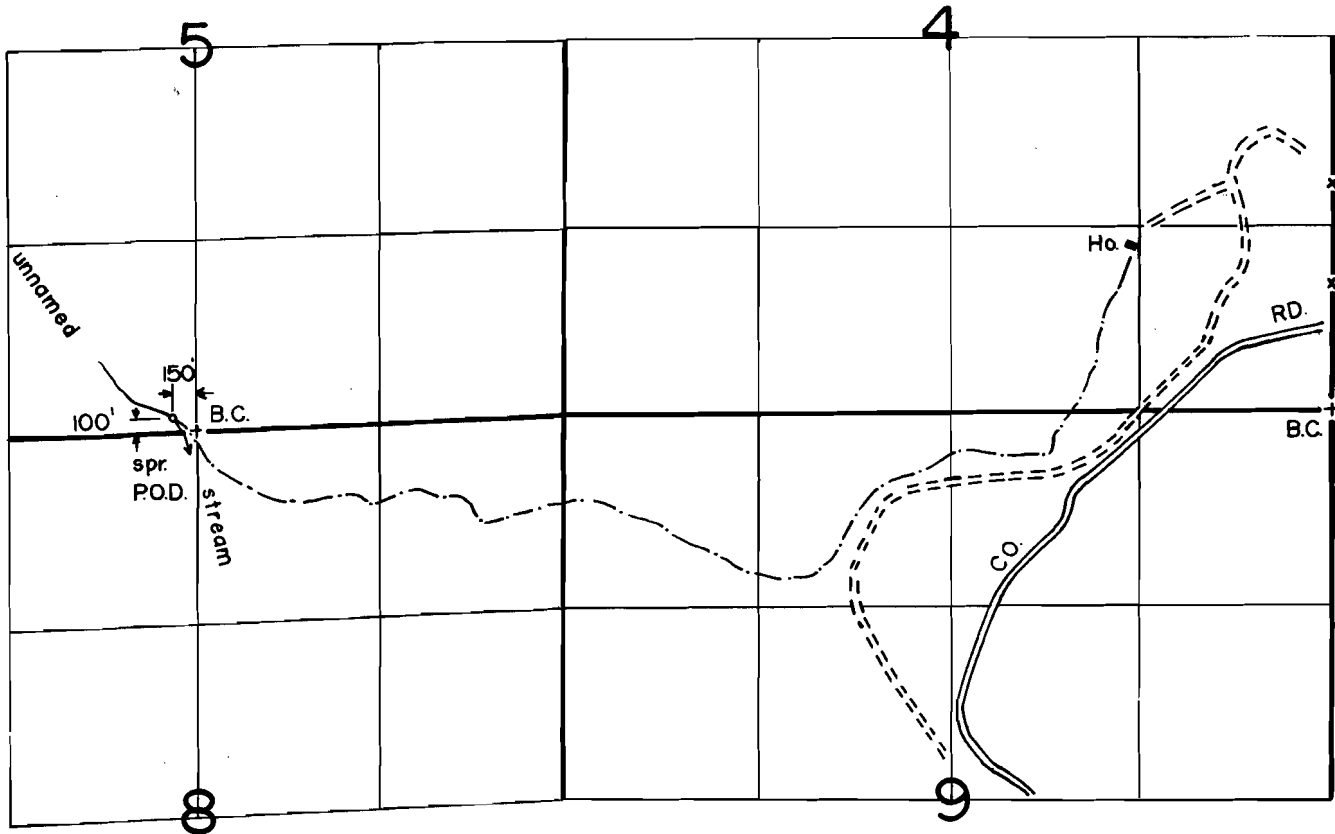

FINAL PROOF SURVEY
UNDER

Application No. 56876 Permit No. 42681

IN NAME OF

H. GAIL SMITH

Surveyed JUNE 20 1990, by B.S. JAMES



1" = 1320'

8-23-90 DSM
41011-280-25R
41011-280-43L