


T. 14 S., R. 9 & 10 W., W.M.

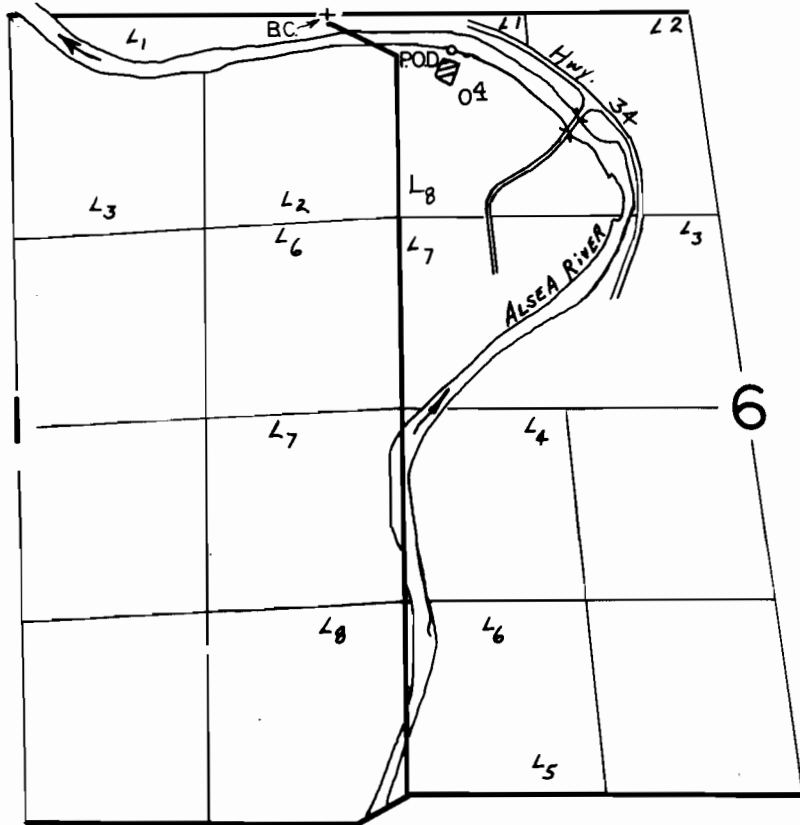

P.O.D. Loc. : 250' S. & 850' E. from NW Cor. Sec. 6.

Scale : 1" = 1320'

FINAL PROOF SURVEY
UNDER

Application No. 59246.. Permit No. 45265.....

IN NAME OF

VERLE CAMPBELL

Surveyed Sept. 20. 1989., by R. KLASSEN.....