


T. 7 S., R. 10 & 11 W., W.M.

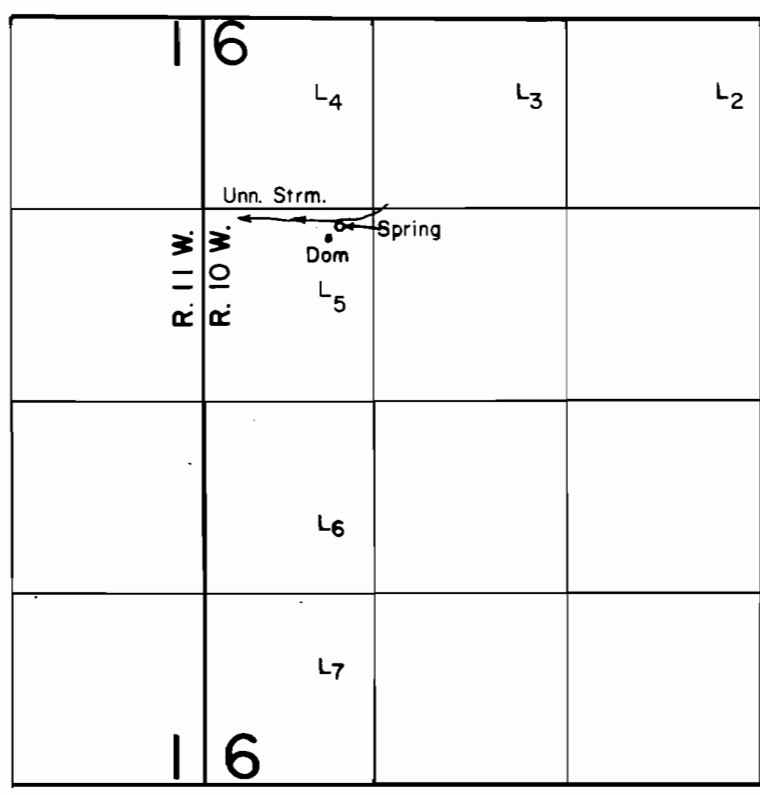

P.O.D. Loc.: 1200' N. & 940' E. from W. 1/4 Cor. Sec. 6.

Scale: 1" = 1320'

FINAL PROOF SURVEY UNDER

Application No. 59329... Permit No. 44655...
IN NAME OF

.....GREEN.....

Surveyed NOV. 16, 1989, by T. Warren