


T.11 S., R.9 W., W.M.

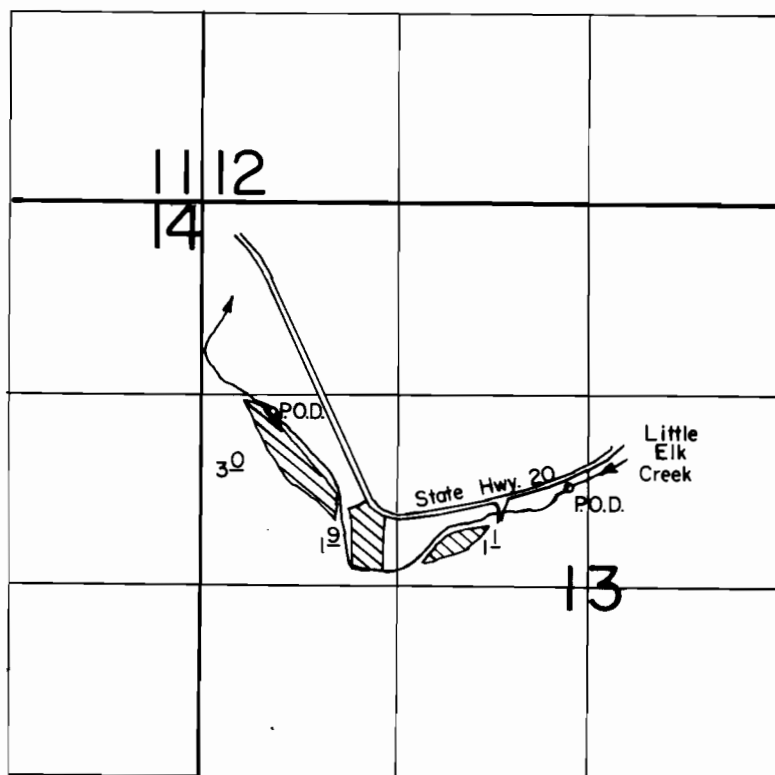

Scale : 1" = 1320'



P.O.D. Loc.: Portable Pumping between 1430' S. & 490' E. and
1950' S. & 2500' E. from NW Cor. Sec. 13.

FINAL PROOF SURVEY **UNDER**

Application No. ~~59468~~... Permit No. ~~44657~~.....
IN NAME OF

MIKE DE LUSE & SHIRLEY PETERS

Surveyed Nov. ~~13~~... 1989, by ~~T. Warren~~.....