


T. 12S., R. 45E., W. M.

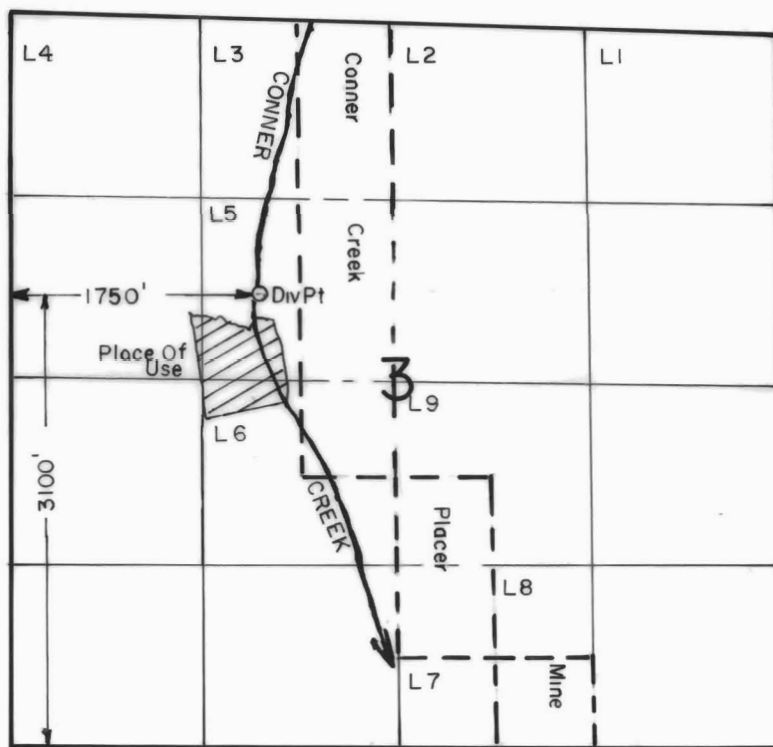

SCALE: 1" = 1320'

FINAL PROOF SURVEY
UNDER

Application No. 60032... Permit No. 44973.....
IN NAME OF

.....NEAL.....MISHLER.....

Surveyed SEPT...21... 1989... by K.KEMP.....