


T. 11 S., R. 9 W., W.M.

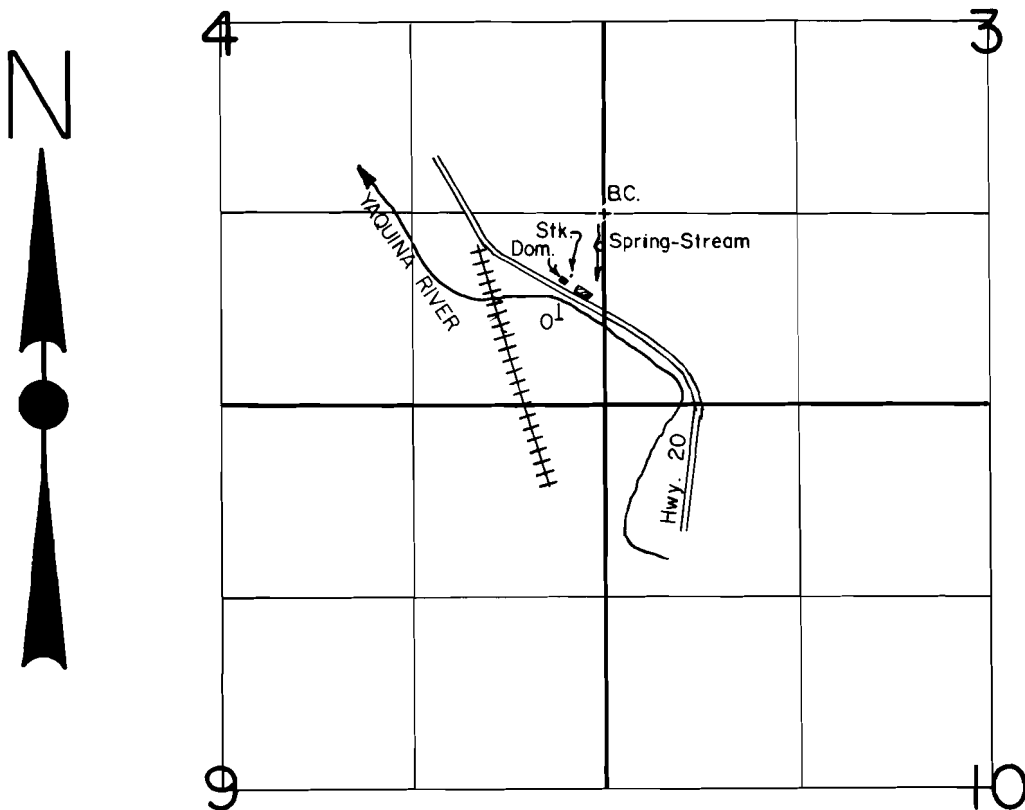

P.O.D. Loc. : 230' S. & 20' W. from NE Cor. SE⁴ SE⁴, Sec. 4

Scale: 1" = 1320'

FINAL PROOF SURVEY **UNDER**

Application No. 60378.. Permit No. 45774.....
IN NAME OF

.....MELODY S. BADZINSKI.

Surveyed Sept. 22. 1989., by R. KLASSEN.....