


T. 3 S., R. 2 E., W. M.

Section 23

SW 1/4 SE 1/4

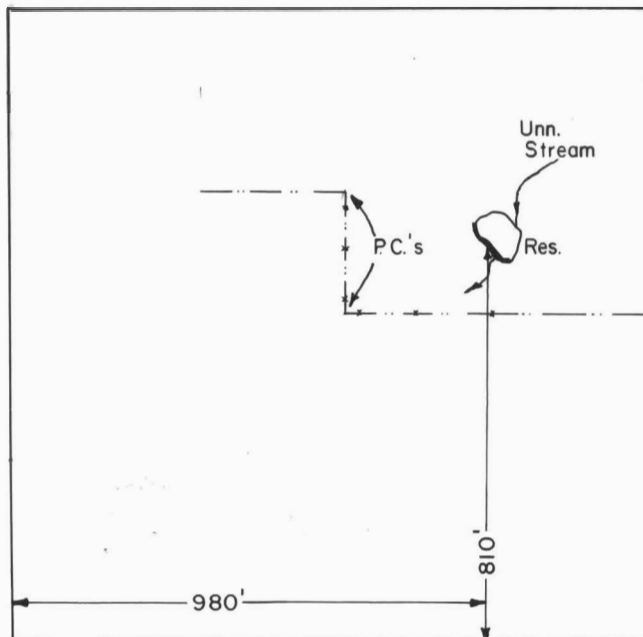

Scale : 1" = 400'

FINAL PROOF SURVEY
UNDER

R-61054 R- 8602
Application No.61055. Permit No.47403.....
IN NAME OF

.....JIMMY & JACQUELINE ARN.....

Surveyed Oct. 31, 1989, by T. Warren.....