


# T. 3 S., R. 2 E., W. M.

## Section 23

SW 1/4 SE 1/4

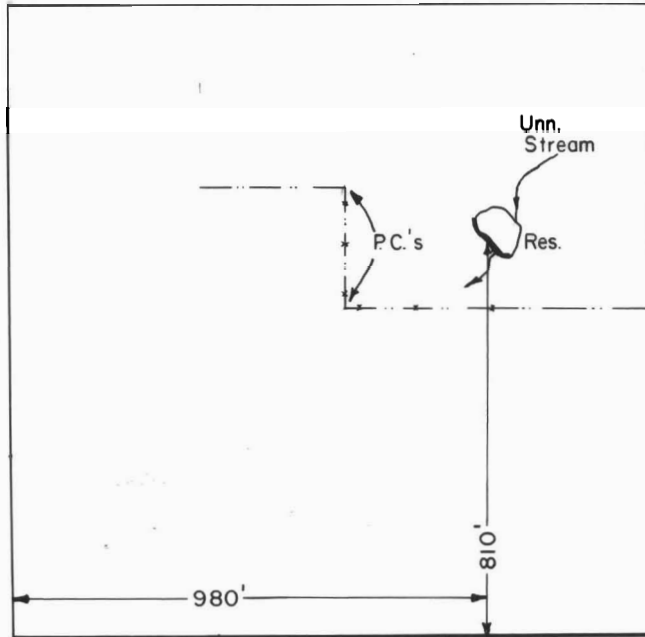

Scale : 1" = 400'

### FINAL PROOF SURVEY UNDER

R-61054                      R-8602  
 Application No. ....61055 Permit No. ....47403.....  
 IN NAME OF

.....JIMMY & JACQUELINE ARN.....

Surveyed Oct. 31, 1989, by T. Warren.....

PTS w/FF  
1/15/89 TAW