


T. 37S., R. 8 & 9E., W.M.

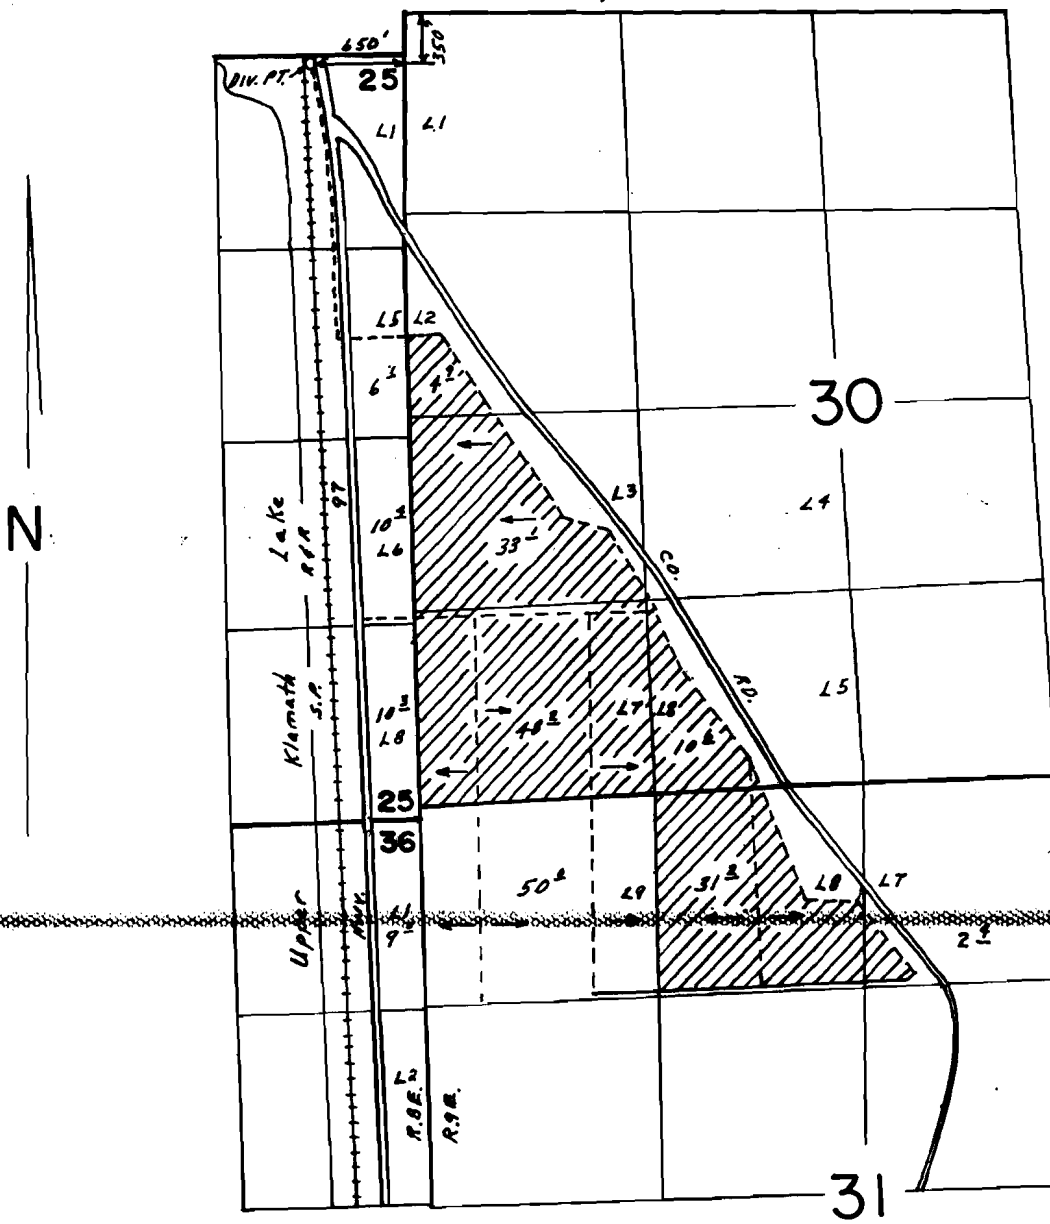

SCALE 1"=1320'

FINAL PROOF SURVEY UNDER

Application No. 61208 Permit No. 45562.....
IN NAME OF

RICHARD R. & CHARLOTTE RODGERS

Surveyed MAY 23, 1988, by B. BISHOP.....

1-25-89

41035-178-179C *L.C.*