


T. 28 S., R. 13 W., W.M.

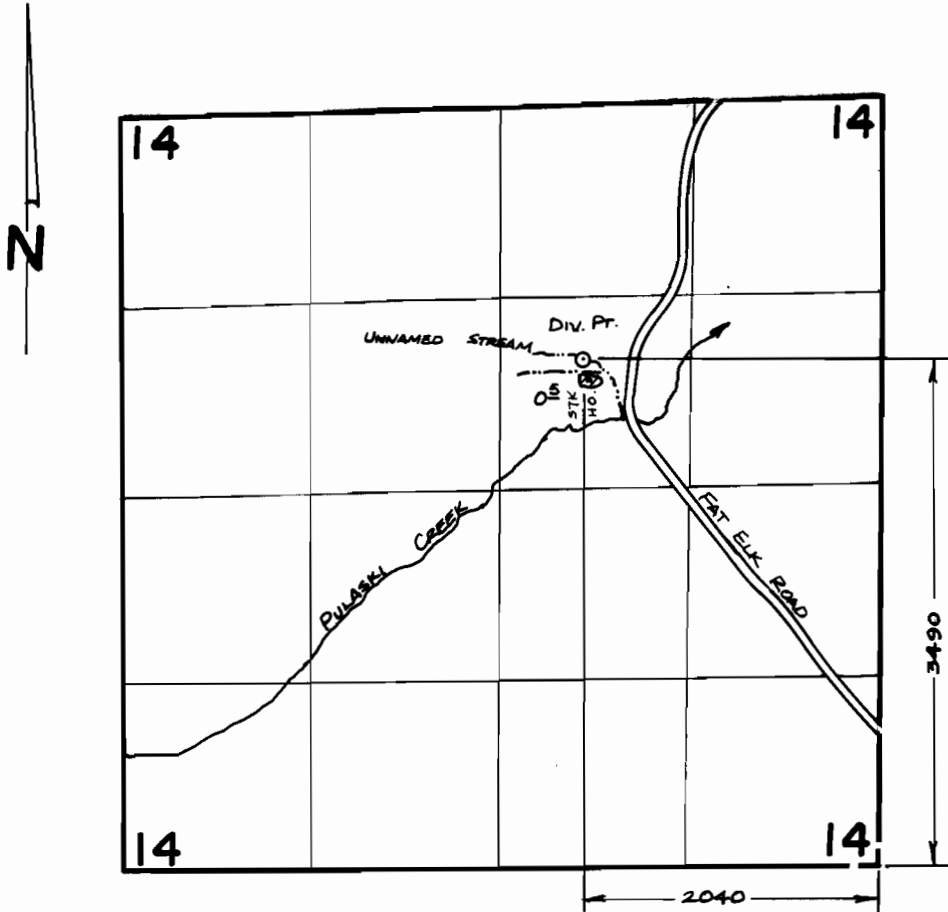

SCALE: 4" = 1 MILE

FINAL PROOF SURVEY
UNDER

Application No. ..62830.. Permit No.47120....
IN NAME OF

.....DARLENE FRANCIS BERG.....

Surveyed ..3/17.,... 19.88., by ...M...SCHMORDE..