


# T. 38 S., R. 5 W., W. M.

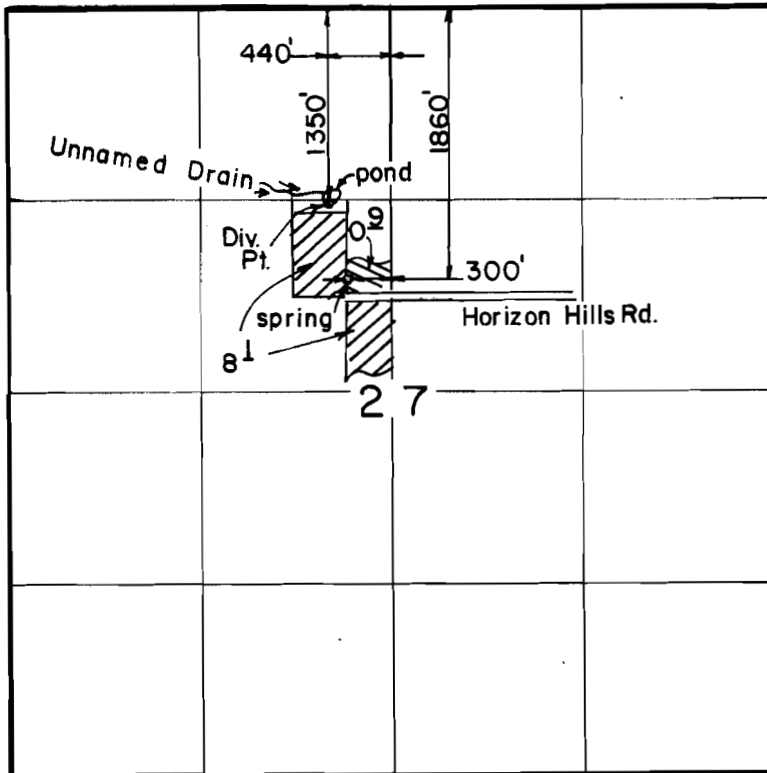

Scale: 1" = 1320'

## FINAL PROOF SURVEY UNDER

Application No. 62980 Permit No. 47443  
IN NAME OF

NOEL M. MANCHESTER

Surveyed AUG. 9 1988, by B. S. JAMES