


T. 26 S., R. 3 W., W. M

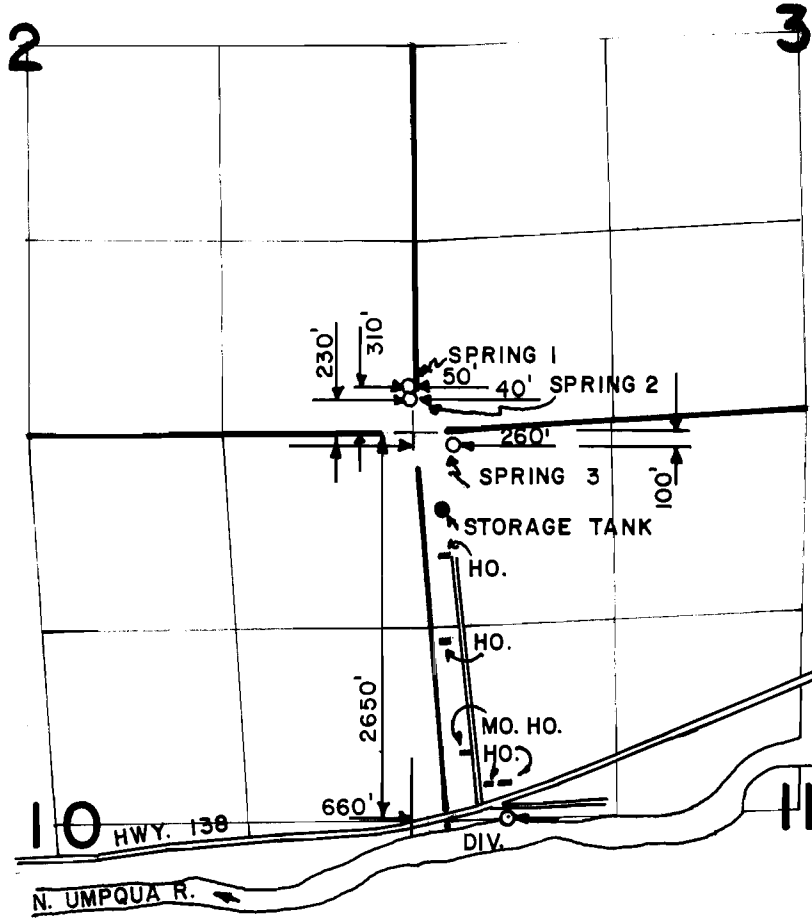

SCALE: 4" = 1 MILE

**FINAL PROOF SURVEY**  
UNDER

Application No. 63000... Permit No. 46928  
IN NAME OF

**HAZEL M. DELAVAL**

Surveyed SEPT. 29 1988, by J. M. SCHMORDE.