




T.9S., R.45E., W.M.

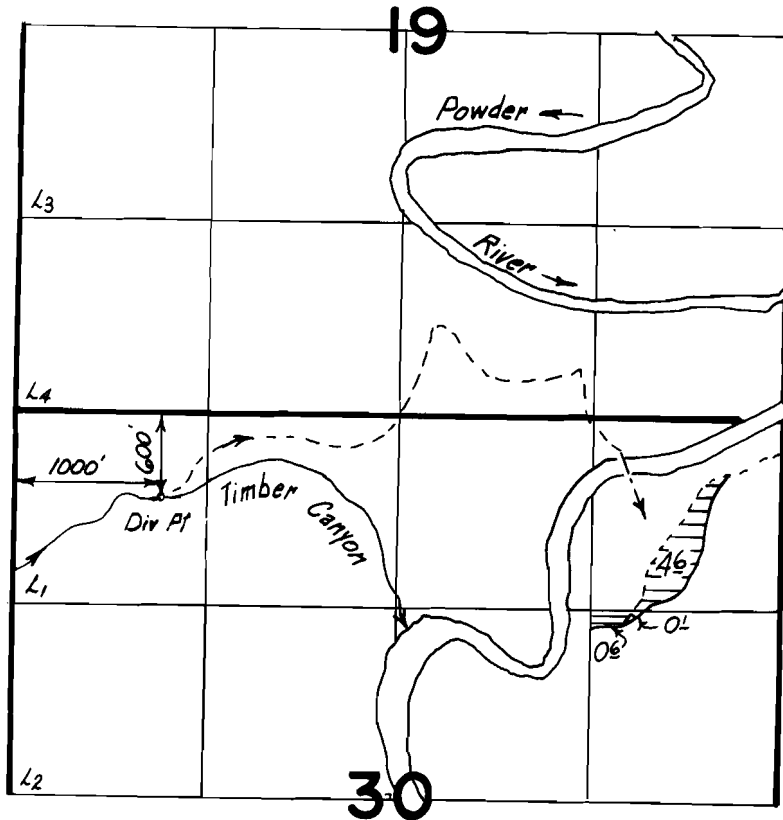

Scale: 1" = 1320'

FINAL PROOF SURVEY
UNDER

-  Primary Irrigation
-  Supplemental Irrigation

Application No. **63027** Permit No. **46847**....
IN NAME OF

.....**JOHN KEATING**.....

Surveyed **10-4** 19**88**, by **Kenn Kemp**.....