



T. 20S., R. 46E., W.M.

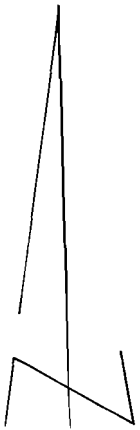

SCALE 1" = 1320

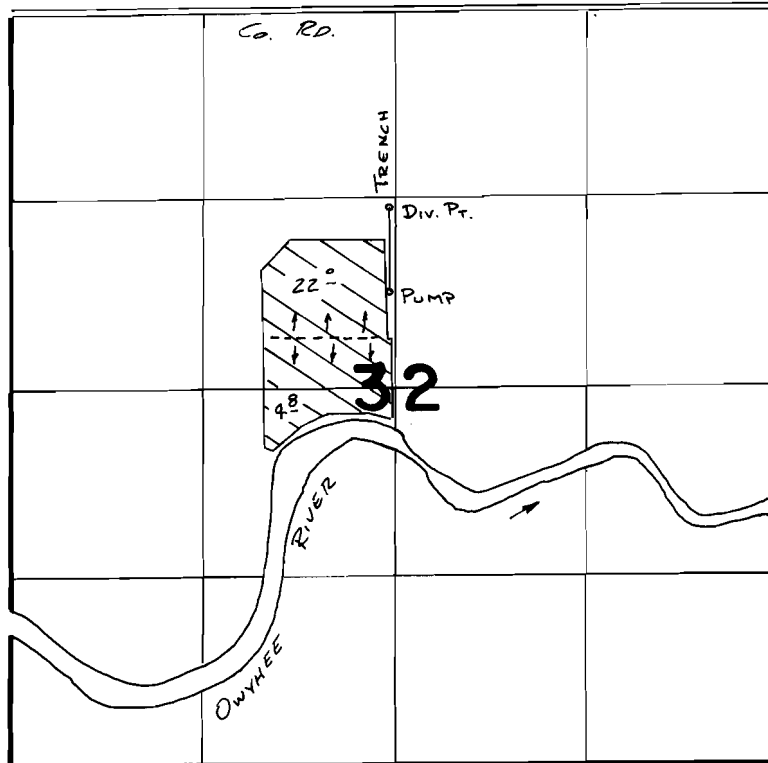

Div. Pt. Loc: 1240' N. & 40' W FROM CENTER SEC 32

FINAL PROOF SURVEY
UNDER

Application No. **63186** Permit No. **46671**
IN NAME OF

ELVER NIELSON

Surveyed 4-20 1988, by V. L. Church