
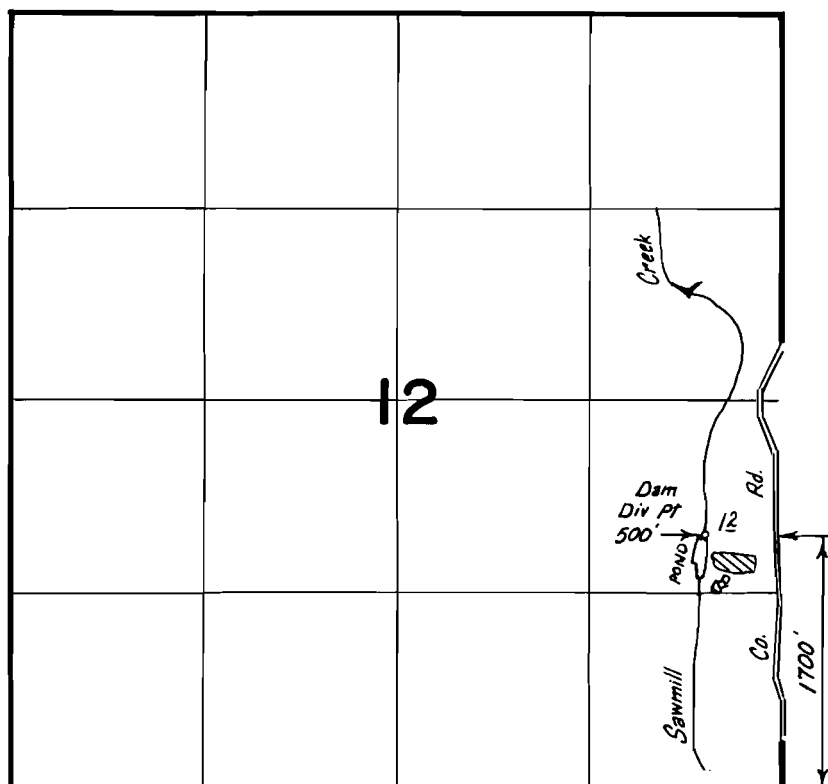


T.8S., R.43E., W.M.

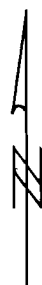

FINAL PROOF SURVEY
UNDER


Scale: 1" = 1320'

R-63214 R-8466
Application No. 63215 Permit No. 46849
IN NAME OF

THOMAS W. DESCHNER & CAROLYN HASLETT

Surveyed 8-31 1988, by Vern Church