


T.8S., R.43E., W.M.

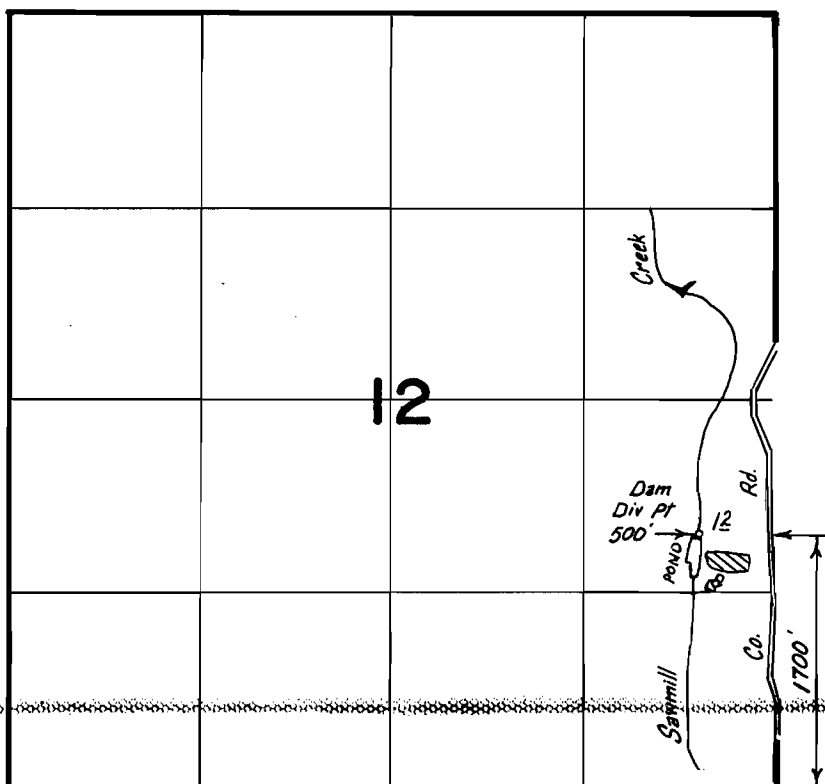

FINAL PROOF SURVEY
UNDER

Scale: 1" = 1320'

R-63214 R-8466
Application No. ~~63215~~... Permit No. ~~46849~~....
IN NAME OF

THOMAS W. DESCHNER & CAROLYN HASLETT

Surveyed ~~8-31~~..... 19~~88~~., by ~~Vern~~..... Church....