


T. 29S., R. 7 W., W. M.

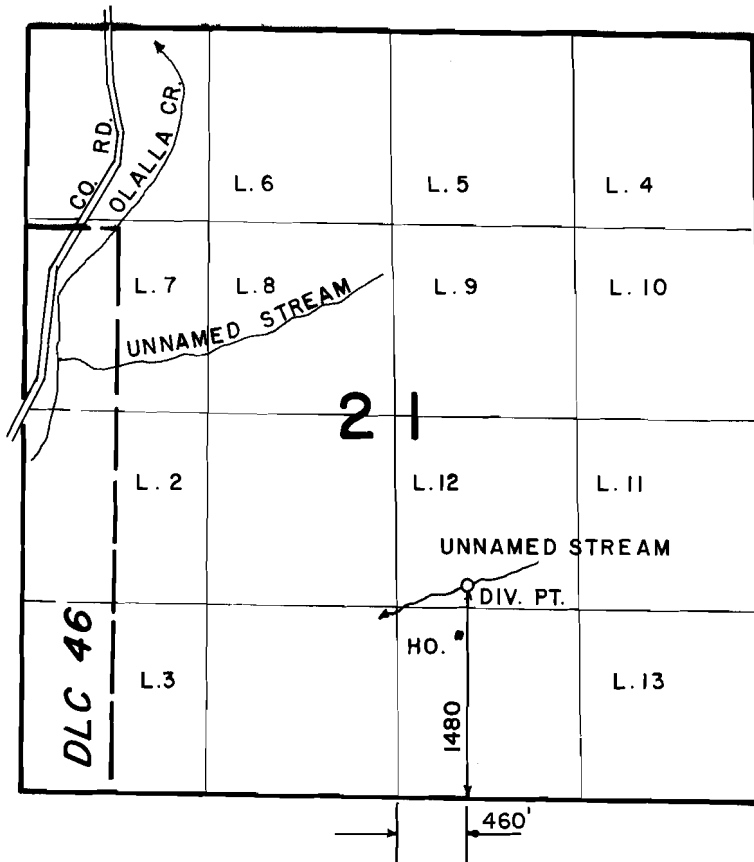

SCALE: 4" = 1 MILE

FINAL PROOF SURVEY UNDER

Application No. 63329 Permit No. 47149
IN NAME OF

LEONARD HERZSTEIN AND SHARON SINDERBRAND

Surveyed JUNE 30 1988, by J. M. SCHMORDE